## FARRIS, HANSEN & ASSOCIATES, INC.

ENGINEERING - ARCHITECTURE - SURVEYING 7 RIDGWAY COURT - P.O. BOX 437 - ELKHORN, WISCONSIN 53121 PHONE: (262) 723-2098 FAX: (262) 723-5886

## PLAT OF SURVEY

PART OF THE NW 1/4 SECTION 1 TOWN 1 NORTH, RANGE 17 EAST CITY OF LAKE GENEVA WALWORTH COUNTY, WISCONSIN

- WORK ORDERED BY -KEEFE REAL ESTATE 751 GENEVA PARKWAY LAKE GENEVA, WI. 53147


P

LEGEND


O = FOUND IRON PIPE STAKE

= FOUND IRON REBAR STAKE

(XXX) = RECORDED AS

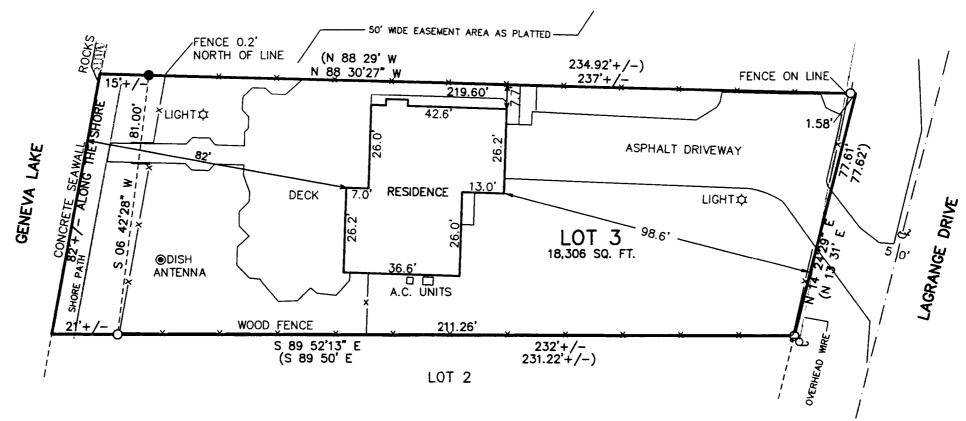

EASEMENTS FOR WATER AND SEWER DOC. NO.'S 498209 AND 563684 RUN WITHIN THE PLATTED ROW FOR LAGRANGE DRIVE.

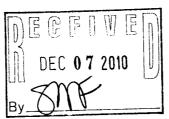

NOTE: COPIES OF THIS MAP TO WHICH THE FOLLOWING CERTIFICATE WILL APPLY SHOW SURVEYOR'S ORIGINAL SEAL AND SIGNATURE IN RED INK. COPIES BY ANY OTHER MEANS MAY HAVE ALTERATIONS WHICH DO NOT REPRESENT THE SURVEYOR'S WORK PRODUCT.

I HEREBY CERTIFY THAT THE ABOVE DESCRIBED PROPERTY HAS BEEN SURVEYED UNDER MY DIRECTION AND THAT THE ABOVE MAP IS A TRUE REPRESENTATION THEREOF AND SHOWS THE SIZE AND LOCATION OF THE PROPERTY, ITS EXTERIOR BOUNDARIES, THE LOCATION OF ALL VISIBLE STRUCTURES, AND DIMENSIONS OF ALL PRINCIPLE BUILDINGS THEREON, BOUNDARY FENCES, APPARENT EASEMENTS, ROADWAYS, AND VISIBLE ENCROACHMENTS, IF ANY. THIS SURVEY IS MADE FOR THE USE OF THE PRESENT OWNERS OF THE PROPERTY, AND ALSO THOSE WHO PURCHASE, MORTGAGE, OR GUARANTEE THE TITLE THERETO WITHIN ONE YEAR FROM THE DATE HEREOF.

DATED: OCTOBER 13, 2010

PETER S. GORDON R.L.S. 2101

3. The land referred to in the Commitment is described as follows:

Lot 3, Lake Geneva East Shore Estates Subdivision located in the Northwest 1/4 of Section 1, T1N, R17E, City of Lake Geneva, Walworth County, Wisconsin.

Tax Key No: ZLE 00003

MAP SCALE IN FEET ORIGINAL 1" = 30'

PROJECT: 8253 DATE: 11-13-2010 SHEET 1 OF 1

/1 [

10/13/2010 X: /Projects/8253/Dcad/survey