PREPARED FOR JOHN LAW REMAX GENEVA REALTY 101 BROAD ST. LAKE GENEVA WI 53147


PLAT OF SURVEY

-OF-

UNIT 10 IN VICTORIAN SQUARE CONDOMINIUM, LOCATED IN SECTION 1, TOWN 1 NORTH, RANGE 17 EAST, CITY OF LAKE GENEVA WALWORTH COUNTY, WISCONSIN.

KROTT SUR VEYING INC.

N3705 WILLOW BEND LANE
LAKE GENEVA WI. 53147
PHONE # (262)248-3697
FAX # (262)249-0639

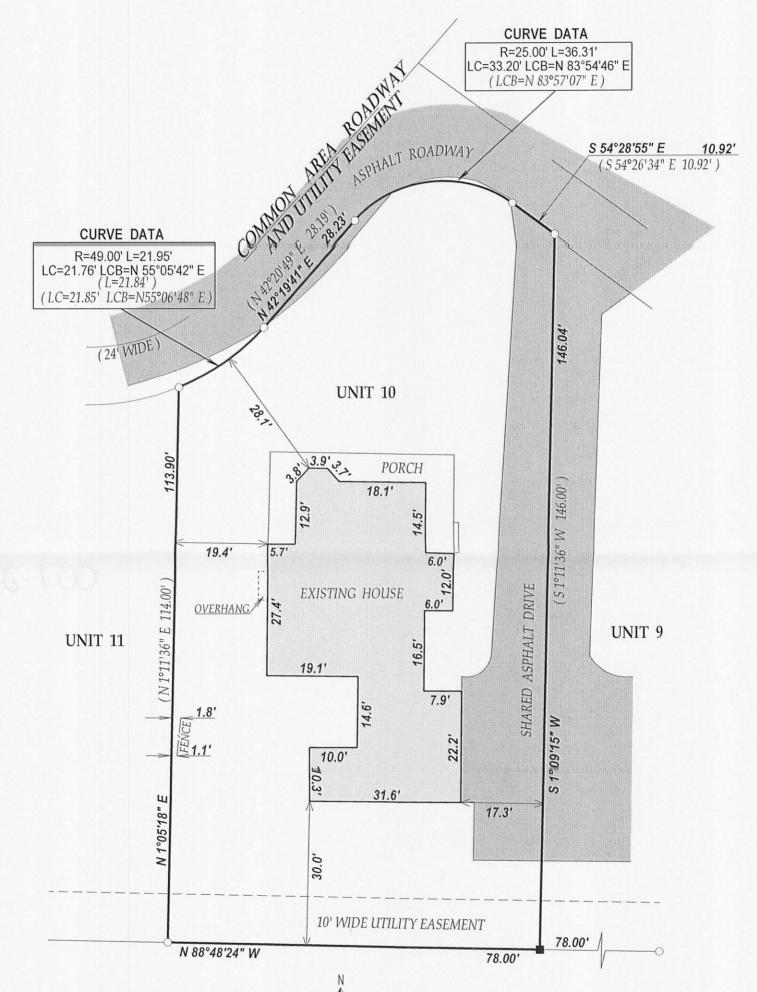




LEGEND

O FOUND IRON PIPE

■ SET IRON BAR


(xx) RECORDED AS TAX ID # ZVS00010 JOB # 11-072

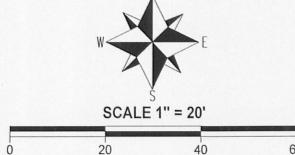

I have surveyed the above-described property and the above map is a true representation thereof and shows the size and location of the property, its exterior boundaries, the location and dimensions of all structures thereon, fences apparent easements and roadways and visible encroachments. if any.

This survey is made for the exclusive use of the present owners of the property, and also those who puchase, mortgage, or insure the title therto within one (1) year from date hereof; and as to them I warrant the accuracy of said survey map.

NOTE: BEARINGS ARE REFRENCED TO THE RECORDED CONDO PLAT

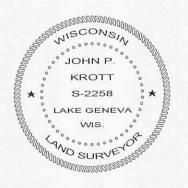

DATED THIS 18th DAY OF MAY 2011.

JOHN KROTT S - 2258 Wisconsin Registered Land Surveyor (original if signed in red)