PREPARED FOR:
CASTLE CREEK HOMES
ATTN. KEVIN SAURER
14 EXCUTIVE CT.
SOUTH BARRINGTON IL 60010


PLAT OF SURVEY

-OF-

LOT 45 OF THE HIGHLANDS OF LAKE GENEVA PART OF THE NORTHWEST 1/4 OF THE SOUTHWEST 1/4 OF SECTION 31, TOWNSHIP 2 NORTH, RANGE 18 EAST, CITY OF LAKE GENEVA, WALWORTH COUNTY, WISCONSIN.

KROTT SURVEYING INC.

N3705 WILLOW BEND LANE LAKE GENEVA WI. 53147 PHONE # (262)248-3697 FAX # (262)249-0639

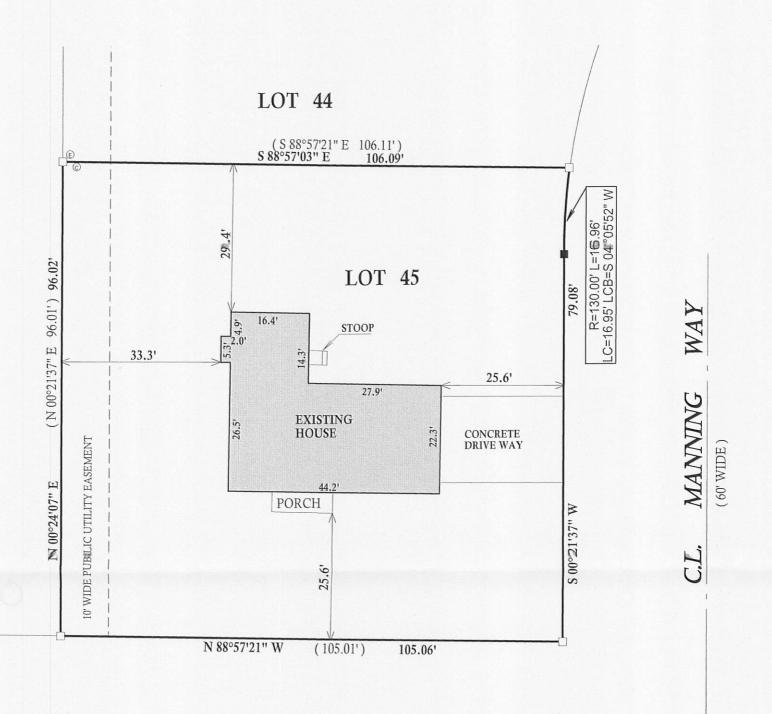


HIGHLAND WAY



LEGEND


- SET IRON BAR
- ☐ FOUND IRON BAR
- © CABLE PEDESTAL
- © ELECTRIC PEDESTAL
- (XX) RECORDED AS

TAX ID # ZHIGH00045 JOB # 09-106UD

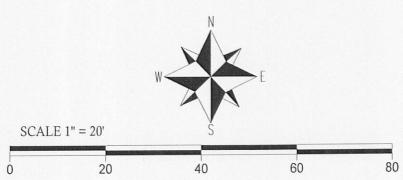

I have surveyed the above-described property and the above map is a true representation thereof and shows the size and location of the property, its exterior boundaries, the location and dimensions of all structures thereon, fences apparent easements and roadways and visible encroachments. if any.

This survey is made for the exclusive use of the present owners of the property, and also those who puchase, mortgage, or insure the title thereo within one (1) year from date hereof; and as to them I warrant the accuracy of said survey map.

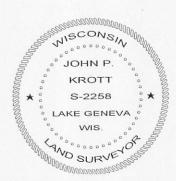

DATE OF LAST REVISION 6 / 16 / 2011
DATED THIS 6th DAY OF AUGUST 2009.

JOHN KROTT S - 2258 Wisconsin Registered Land Surveyor (original if signed in red)

007-2817