
## HAROLD H. KOLB

REGISTERED PROFESSIONAL LAND SURVEYOR LAKE GENEVA, WISCONSIN

OAK HILL DRIVE

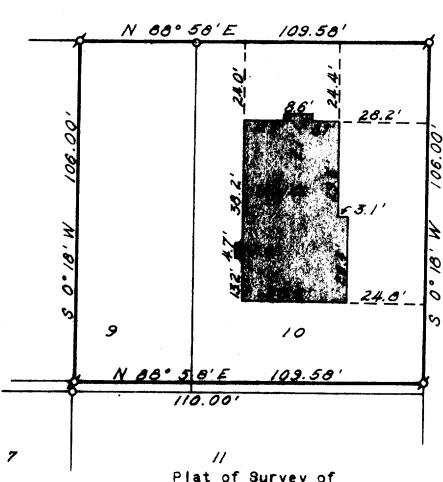

Plat of Survey of

Part of Lots 9 and 10, McKenna Addition to the city of Lake Geneva, Walworth County, Wisconsin.

## LEGEND

IRON PIPE FOUND

IRON PIPE PLACED

CONCRETE MONUMENT



I, HAROLD H. KOLB, DO HEREBY CERTIFY THAT I HAVE SURVEYED THE PROPERTY HEREON DESCRIBED ACCORDING TO THE OFFICIAL RECORDS, AND THAT THE PLAT HEREON IS A CORRECT REPRESENTATION OF THE LOT LINES, and the principle lines of the buildings thereon.

HAROLD H. KOLB

WISCONSIN REGISTERED LAND SURVEYOR, \$-187

7-282

2MC-10