
PREPARED FOR CINDY MAHER REMAX LAKE GENEVA 101 BROAD ST. SUITE 102 LAKE GENEVA WI. 53147

## PLAT OF SURVEY

-OF-

LOT 5 IN BARBARA JEAN ESTATES, A SUBDIVISION LOCATED IN THE NORTHEAST 1/4 OF SECTION 1, TOWN 1 NORTH, RANGE 17 EAST, IN THE CITY OF LAKE GENEVA, WALWORTH COUNTY, WISCONSIN.


KROTT SURVEYING INC. N3705 WILLOW BEND LANE LAKE GENEVA WI. 53147 PHONE # (262)248-3697 FAX # (262)249-0639

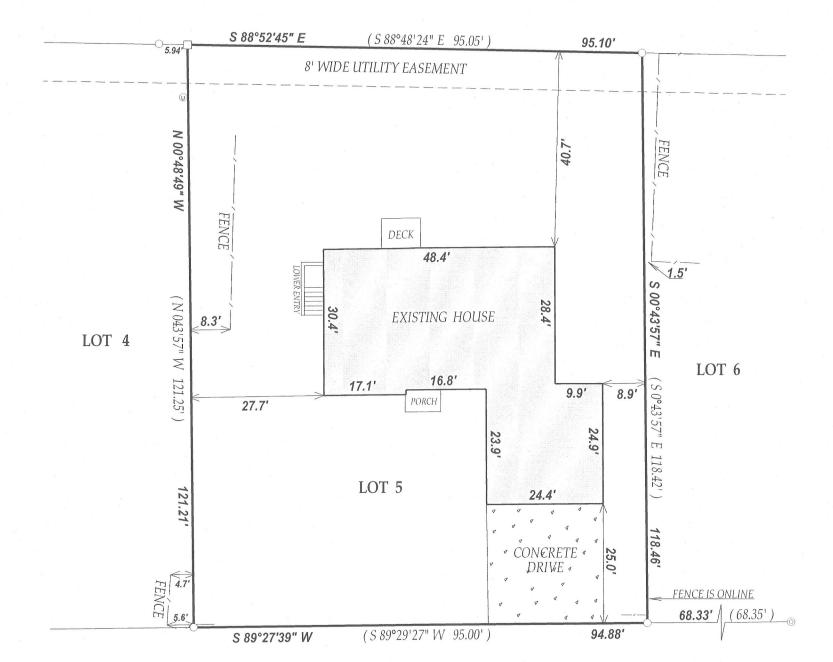

DRIVE SUE C.L.ANN(60' WIDE)




## SCALE 1" = 20'

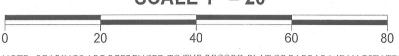

NOTE: BEARINGS ARE REFRENCED TO THE RECORD PLAT OF BARBARA JEAN ESTATES

I have surveyed the above-described property and the above map is a true representation thereof and shows the size and location of the property, its exterior boundaries, the location and dimensions of all structures thereon, fences apparent easements and roadways and visible encroachments. if any.

This survey is made for the exclusive use of the present owners of the property, and also those who puchase, mortgage, or insure the title therto within one (1) year from date hereof; and as to them I warrant the accuracy of said survey map.

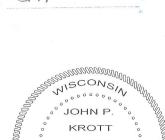

APR 1 8 2012



DATED THIS 21st DAY OF MARCH 2012.

JOHN KROTT S - 2258 Wisconsin Registered Land Surveyor (original if signed in red)

(XX) RECORDED AS TAX ID # ZJ00005 JOB # 12-027

LEGEND

□ FOUND IRON BAR

O FOUND 1" DIA. IRON PIPE

◎ FOUND 2" DIA. IRON PIPE

UTILITY PEDESTALS

