

PREPARED FOR
ANNE PREJNA REALTY
7313 KEYSTONE RD.
RICHMOND, IL 60071



PLAT OF SURVEY

-OF-

LOT 15, BLOCK 1 OF MCKENNA ADDITION LOCATED IN THE
CITY OF LAKE GENEVA, WALWORTH COUNTY, WISCONSIN.

KROTT SURVEYING INC.

N3705 WILLOW BEND LANE
LAKE GENEVA WI. 53147
PHONE # (262)248-3697
FAX # (262)249-0639

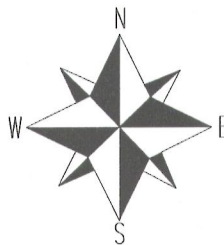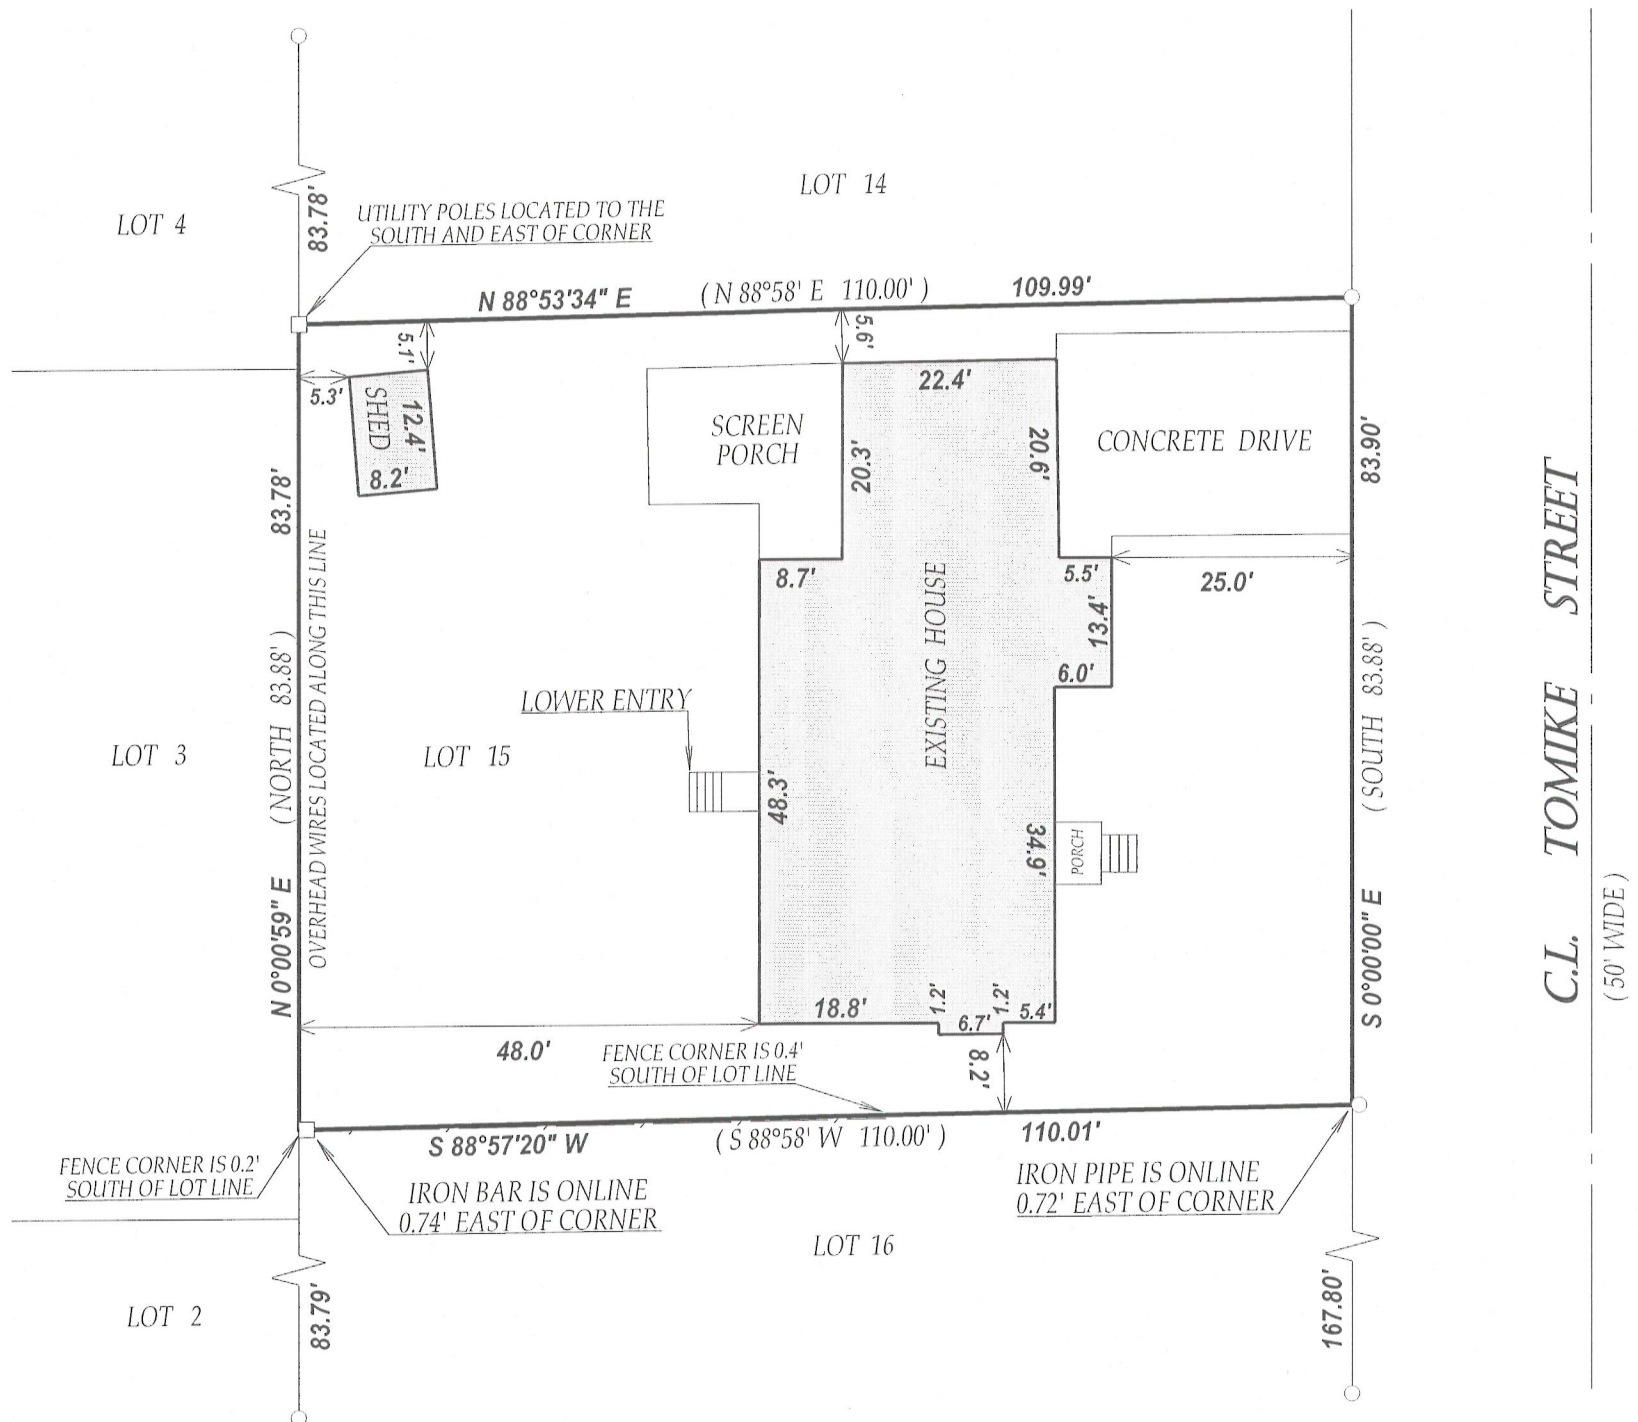


SCALE 1" = 20'

0 20 40 60

NOTE BEARINGS REFERENCED TO THE RECORDED PLAT OF MCKENNA ADD. AND THE EAST LINE OF LOT 15 BLOCK 1, WAS ASSUMED TO BE NORTH-SOUTH

I have surveyed the above-described property and the above map is a true representation thereof and shows the size and location of the property, its exterior boundaries, the location and dimensions of all structures thereon, fences apparent easements and roadways and visible encroachments, if any.

This survey is made for the exclusive use of the present owners of the property, and also those who purchase, mortgage, or insure the title thereto within one (1) year from date hereof; and as to them I warrant the accuracy of said survey map.

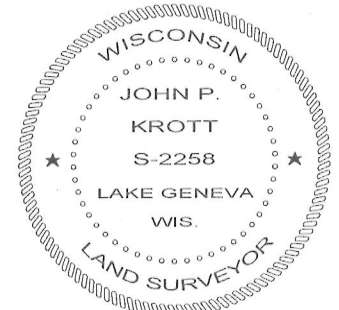

DATED THIS 10th DAY OF FEBRUARY 2010.
DATE OF LAST REVISION: 8/07/2012

John P. Krott

JOHN KROTT S - 2258
Wisconsin Registered Land Surveyor
(original if signed in red)

LEGEND

- FOUND IRON PIPE
- FOUND IRON BAR

(XX) RECORDED AS

TAX ID # ZMC00015

JOB # 10-026UD

007-2885