

PREPARED FOR
DAVID SHOUDER
1191 ROMIN RD.
LAKE GENEVA WI. 53147



PLAT OF SURVEY

-OF-

KROTT SURVEYING INC.

N3705 WILLOW BEND LANE
LAKE GENEVA WI. 53147
PHONE # (262)248-3697
FAX # (262)249-0639

A PARCEL OF LAND LOCATED IN THE NORTHWEST 1/4 OF SECTION 6,
TOWN 1 NORTH, RANGE 18 EAST, AND DESCRIBED AS FOLLOWS:
COMMENCING AT THE WEST 1/4 CORNER OF SAID SECTION 6, TOWN
1 NORTH, RANGE 18 EAST, THENCE N 87°47' E 355.12 FEET; N 1°21' W
33.00 FEET TO THE PLACE OF BEGINNING OF LAND TO BE DESCRIBED,
THENCE CONTINUE N 1°21' W 125.00 FEET, THENCE N 87°47' E 95.00 FEET,
S 1°21' E 125.00 FEET, THENCE S 1°21' W 95.00 FEET TO THE PLACE OF
BEGINNING, SAID LAND IN THE CITY OF LAKE GENEVA, WALWORTH
COUNTY, WISCONSIN.

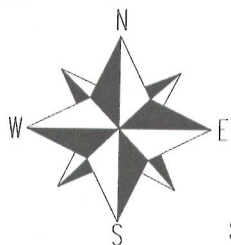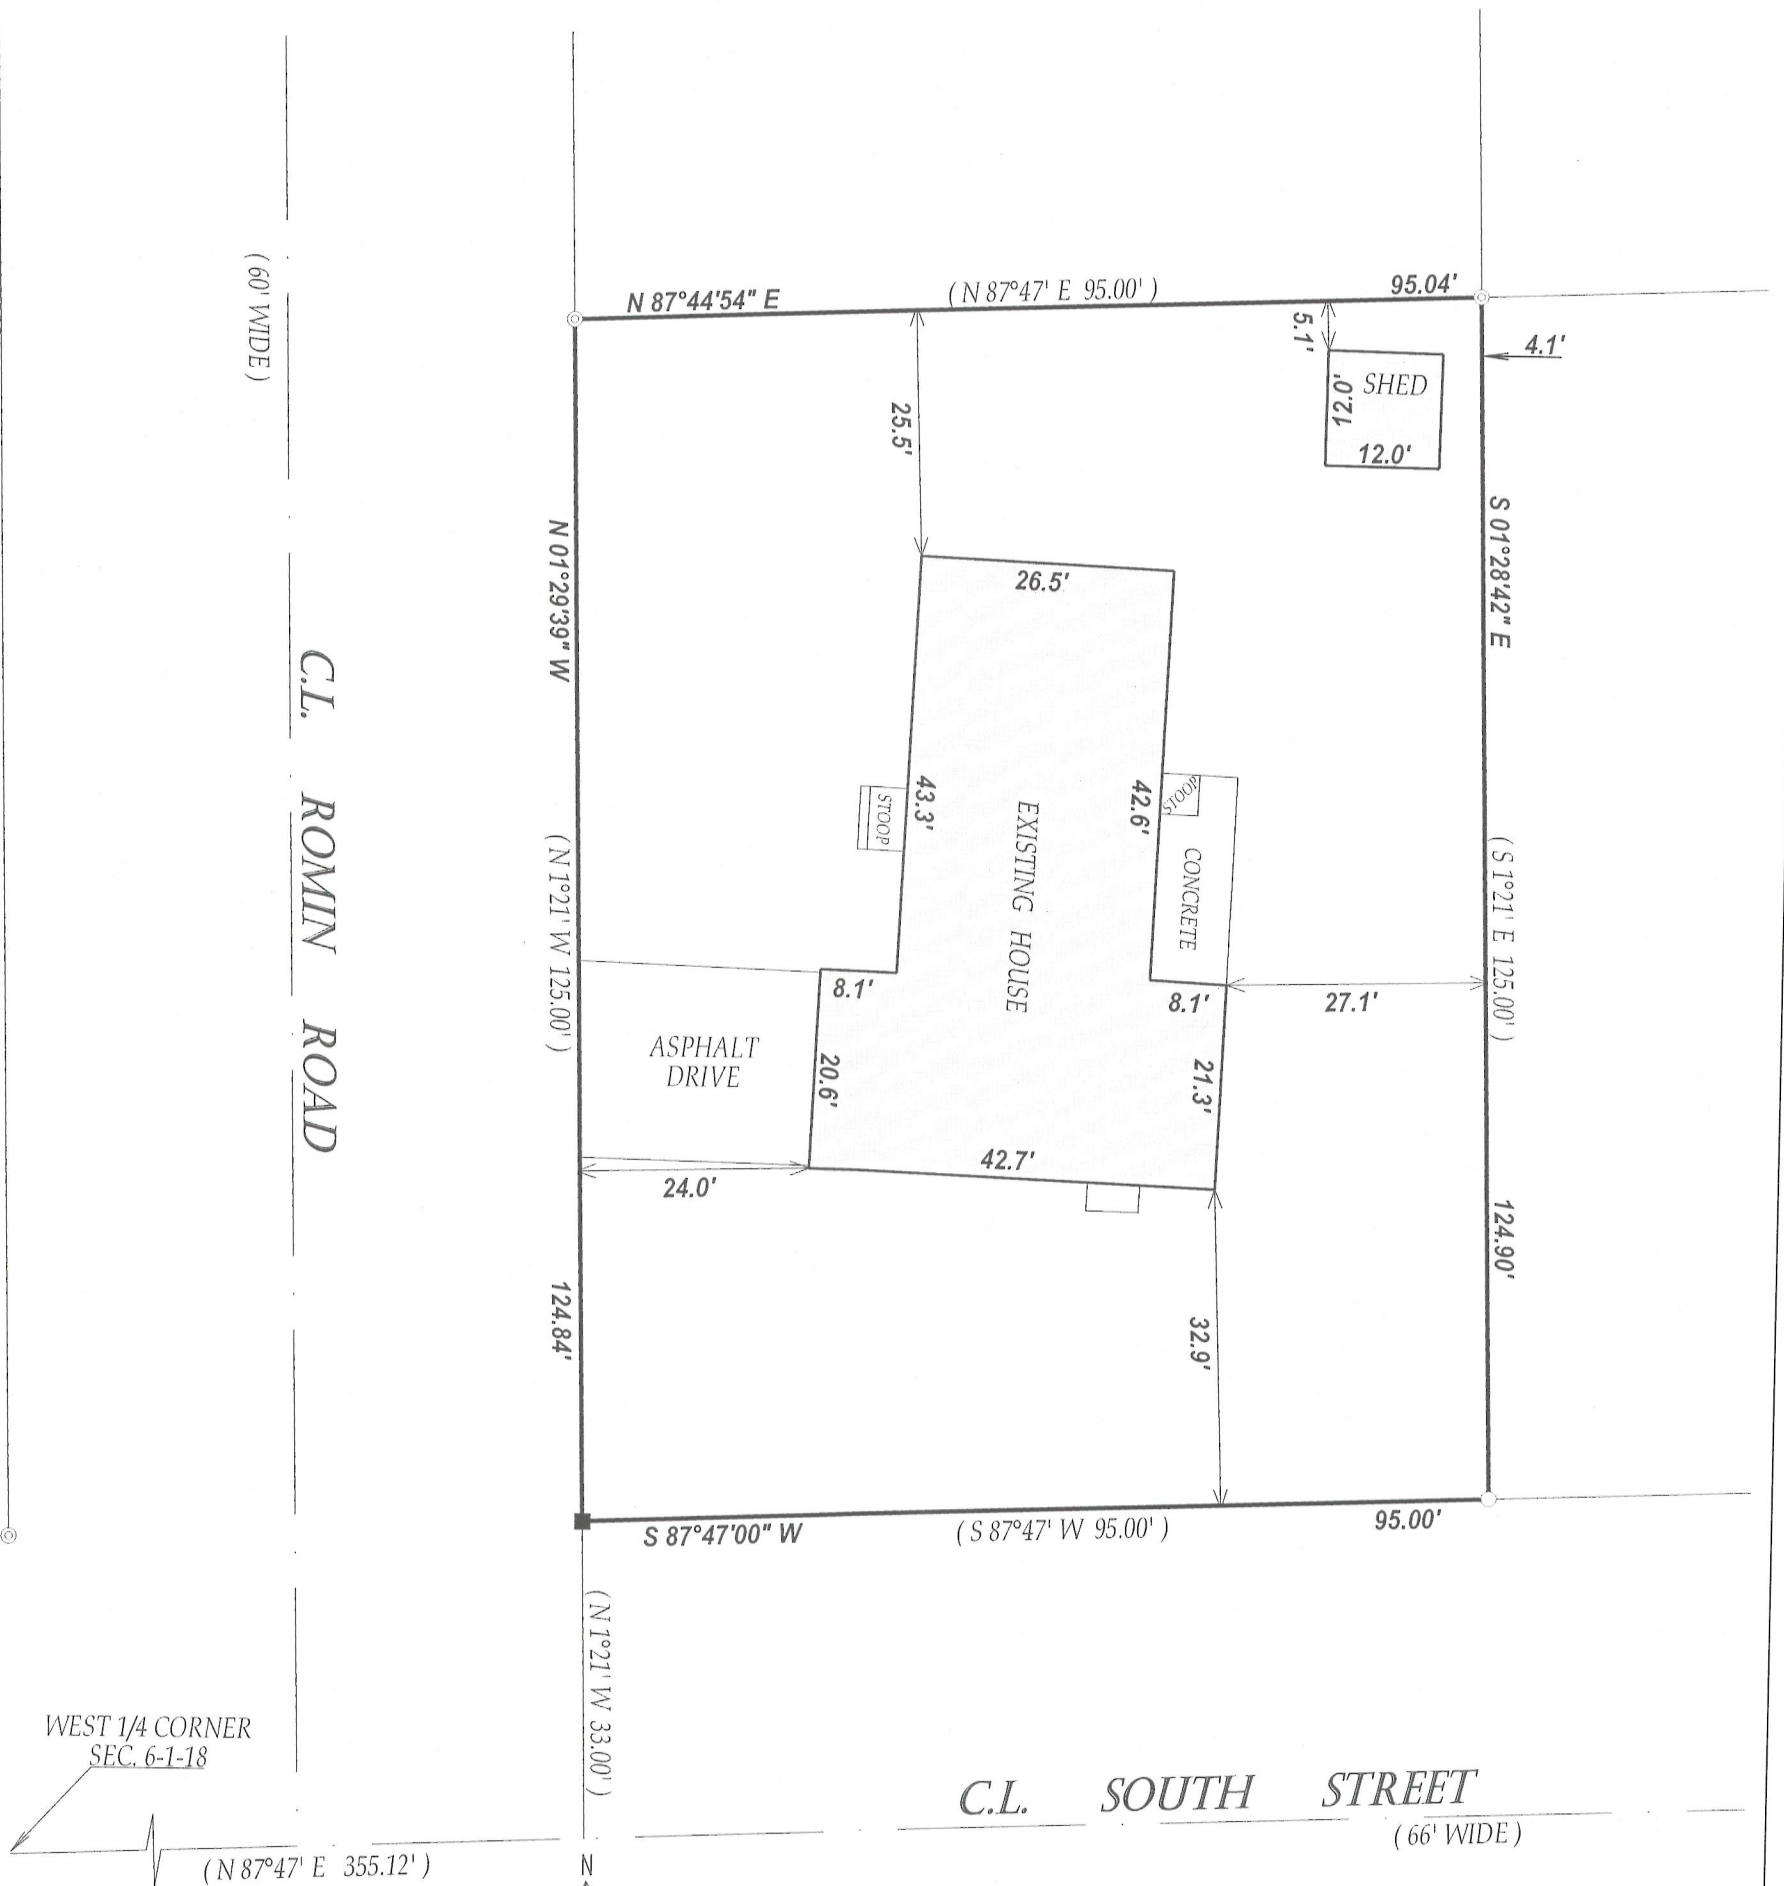


SCALE 1" = 20'



NOTE: BEARINGS ARE REFERENCED TO PREVIOUS SURVEY RECORDS

I have surveyed the above-described property and the above map is a true representation thereof and shows the size and location of the property, its exterior boundaries, the location and dimensions of all structures thereon, fences apparent easements and roadways and visible encroachments, if any.

This survey is made for the exclusive use of the present owners of the property, and also those who purchase, mortgage, or insure the title thereto within one (1) year from date hereof; and as to them I warrant the accuracy of said survey map.

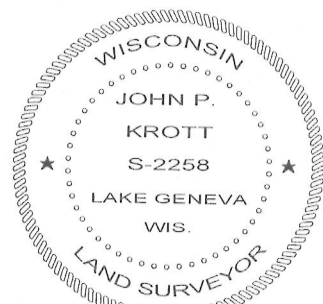

DATED THIS 27th DAY OF AUGUST 2012

John P. Krott

JOHN KROTT S - 2258
Wisconsin Registered Land Surveyor
(original if signed in red)

007-2915

LEGEND

- FOUND 1" DIA. IRON PIPE
- ⊙ FOUND 2" DIA. IRON PIPE
- SET IRON BAR

(XX) RECORDED AS
TAX ID # ZYUP00133
JOB # 12-116