



**PLAT OF SURVEY**  
 LOT 4 OF COMMERCIAL COURT SUBDIVISION  
 LOCATED IN THE NW 1/4 & SW 1/4 OF THE SE 1/4 SECTION 31  
 TOWN 2 NORTH, RANGE 18 EAST, CITY OF LAKE GENEVA  
 WALWORTH COUNTY, WISCONSIN



ZCOM 00004  
 007-2923

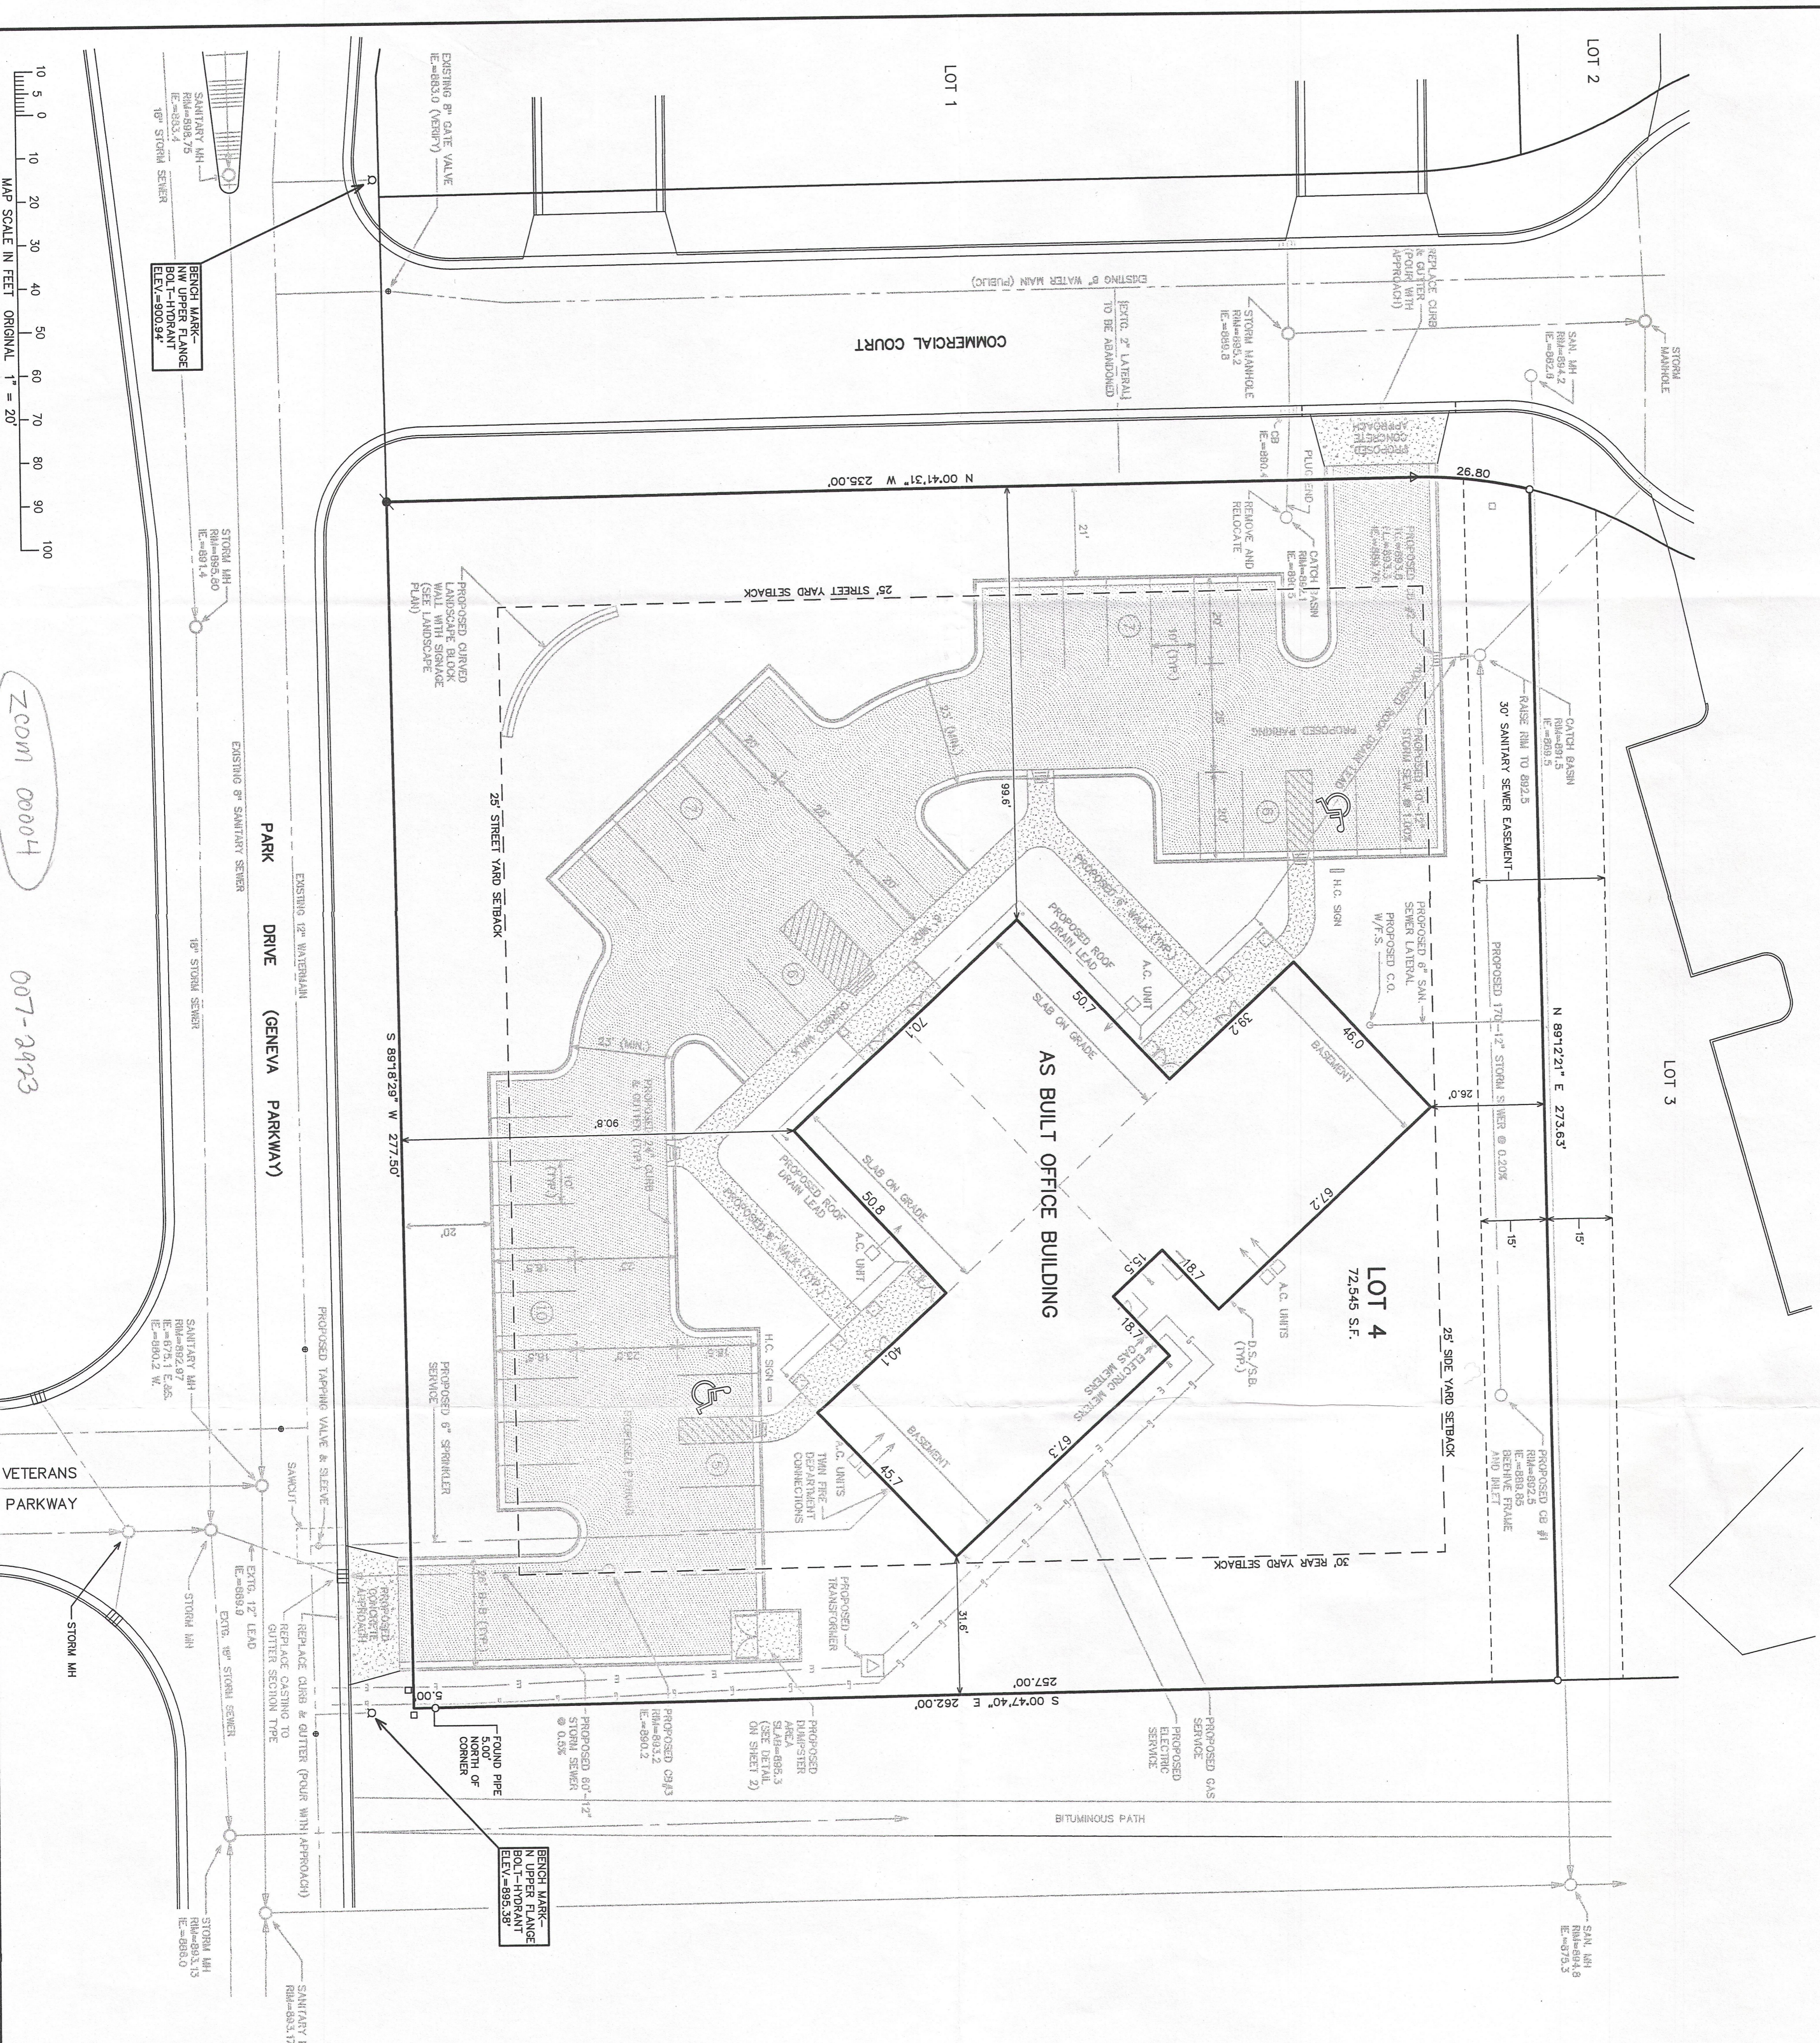


DATE: FEBRUARY 27, 2013  
 PROJECT NO. 5767.13  
 DATE 02-26-2013  
 SHEET NO. 1 OF 1

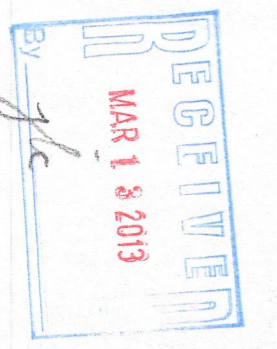

NOTE: INTERIOR DETAIL AND UTILITIES FROM APPROVED SITE PLAN NO. 10-11-AS-BUILT OF DETAILS. EXISTING BUILDING LOCATION AS BUILT 02-26-2013.

LEGEND  
 ▲ = SET NAIL IN PAVEMENT  
 ● = SET IRON REBAR STAKE  
 ○ = FOUND IRON REBAR STAKE  
 ○ = FOUND IRON PIPE STAKE  
 [xxx] = RECORDED AS

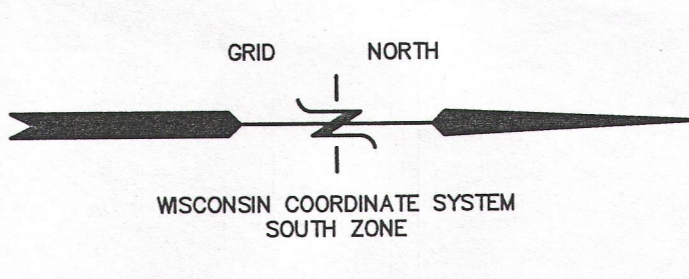

PROJECT NO.	5767.13
DATE	02-26-2013
SHEET NO.	1 OF 1

REVISIONS	
-----------	--

**FARRIS, HANSEN & ASSOCIATES, INC.**  
 Engineering, Architecture, Surveying  
 7 Ridgway Court P.O. Box 437  
 ELKHORN, WISCONSIN 53121  
 Office: (262) 723-2098  
 Fax: (262) 723-5886

— ORDERED BY —  
 FAIRWYN  
 BRIAN POLLARD  
 875 TOWNLINE ROAD SUITE 103  
 LAKE GENEVA, WI.

**TSMO OFFICE COMPLEX**  
 LOT 4 OF COMMERCIAL COURT SUBDIVISION  
 CITY OF LAKE GENEVA  
 WALWORTH COUNTY, WISCONSIN

