LAND-MARK SURVEYING Mark L. Miritz


Wisconsin Registered Land Surveyor S-2582

N9330 Knuteson Drive Whitewater, WI 53190 Phone:(262)495-3284 FAX: (262) 495-8421



LOT 5, TOWNLINE TRAILS SUBDIVISION, LOCATED IN PART OF THE NORTHEAST 1/4 OF THE NORTHWEST 1/4 AND THE SOUTHEAST 1/4 OF THE NORTHWEST 1/4 OF SECTION 6, ALL IN TOWN 1 NORTH, RANGE 18 EAST, CITY OF LAKE GENEVA, WALWORTH COUNTY, WISCONSIN

ORDERED BY: BASSO BUILDERS, INC. **405 SKYLINE ROAD LAKE GENEVA, WI 53147**

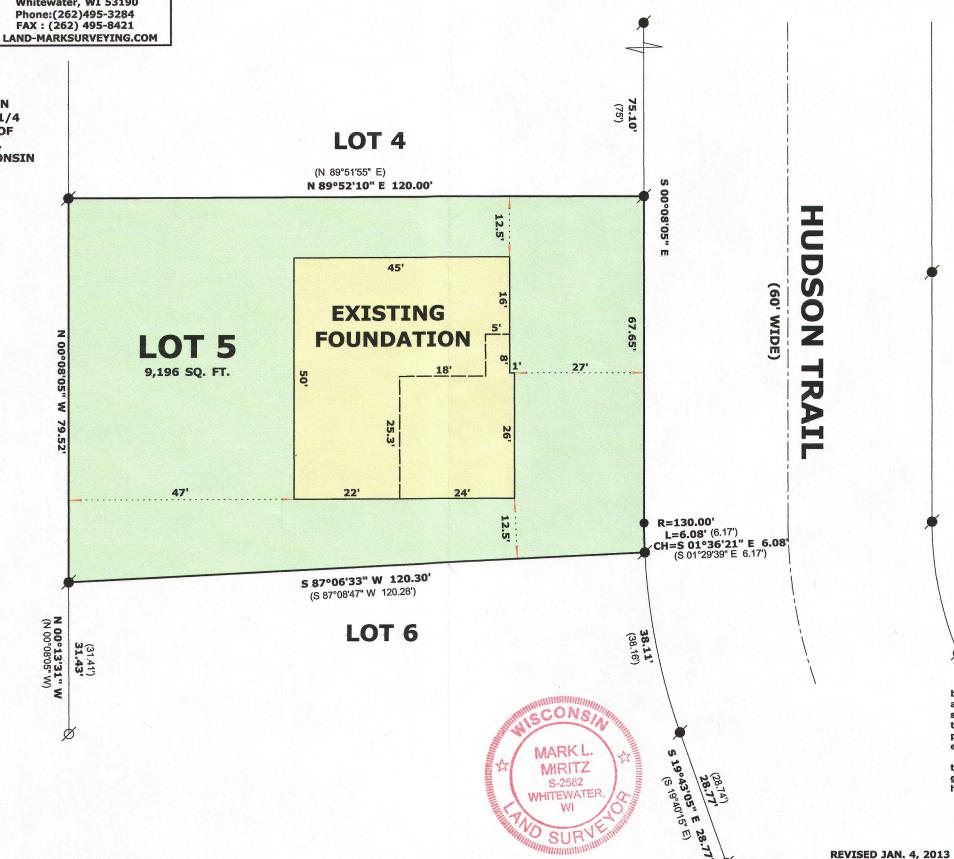



LAND SURVEYOR S-2582 TO SHOW FOUNDATION

"AS BUILT"

(xx)

MARK L. MIRITZ

WISCONSIN REGISTERED

LEGEND

FOUND IRON PIPE 1 5/16" FOUND IRON ROD 1/2"

SET IRON ROD, 18" LONG 3/4"

WOOD STAKE SET 10' BUILDING OFFSET

RECORDED AS DIMENSION

SCALE: 1 INCH = 20 FEET "I hereby certify that the above described property has been surveyed by me or under my direction and that the above map is a true representation thereof and shows the

size and location of the property, its exterior boundaries, the location of all visible structures and dimensions of all principal buildings thereon, boundary fences, apparent easements, roadways and visible encroachments, if any."

"This survey is made for the use of the present owners of

the property, and also those who purchase, mortgage, or guarantee the title thereto within one year from date hereof."

DATE: OCT. 19, 2012 JOB NO. 12.1008

THE WEST LINE OF HUDSON TRAIL WAS ASSUMED TO BEAF S 0°08'05" E AS PLATTED