


**HAROLD H. KOLB**REGISTERED PROFESSIONAL LAND SURVEYOR  
LAKE GENEVA, WISCONSIN**DODGE STREET**

## PLAT OF SURVEY OF

Lot 127, Sturwood Addition Number 7,  
City of Lake Geneva, Walworth County  
Wisconsin.

N

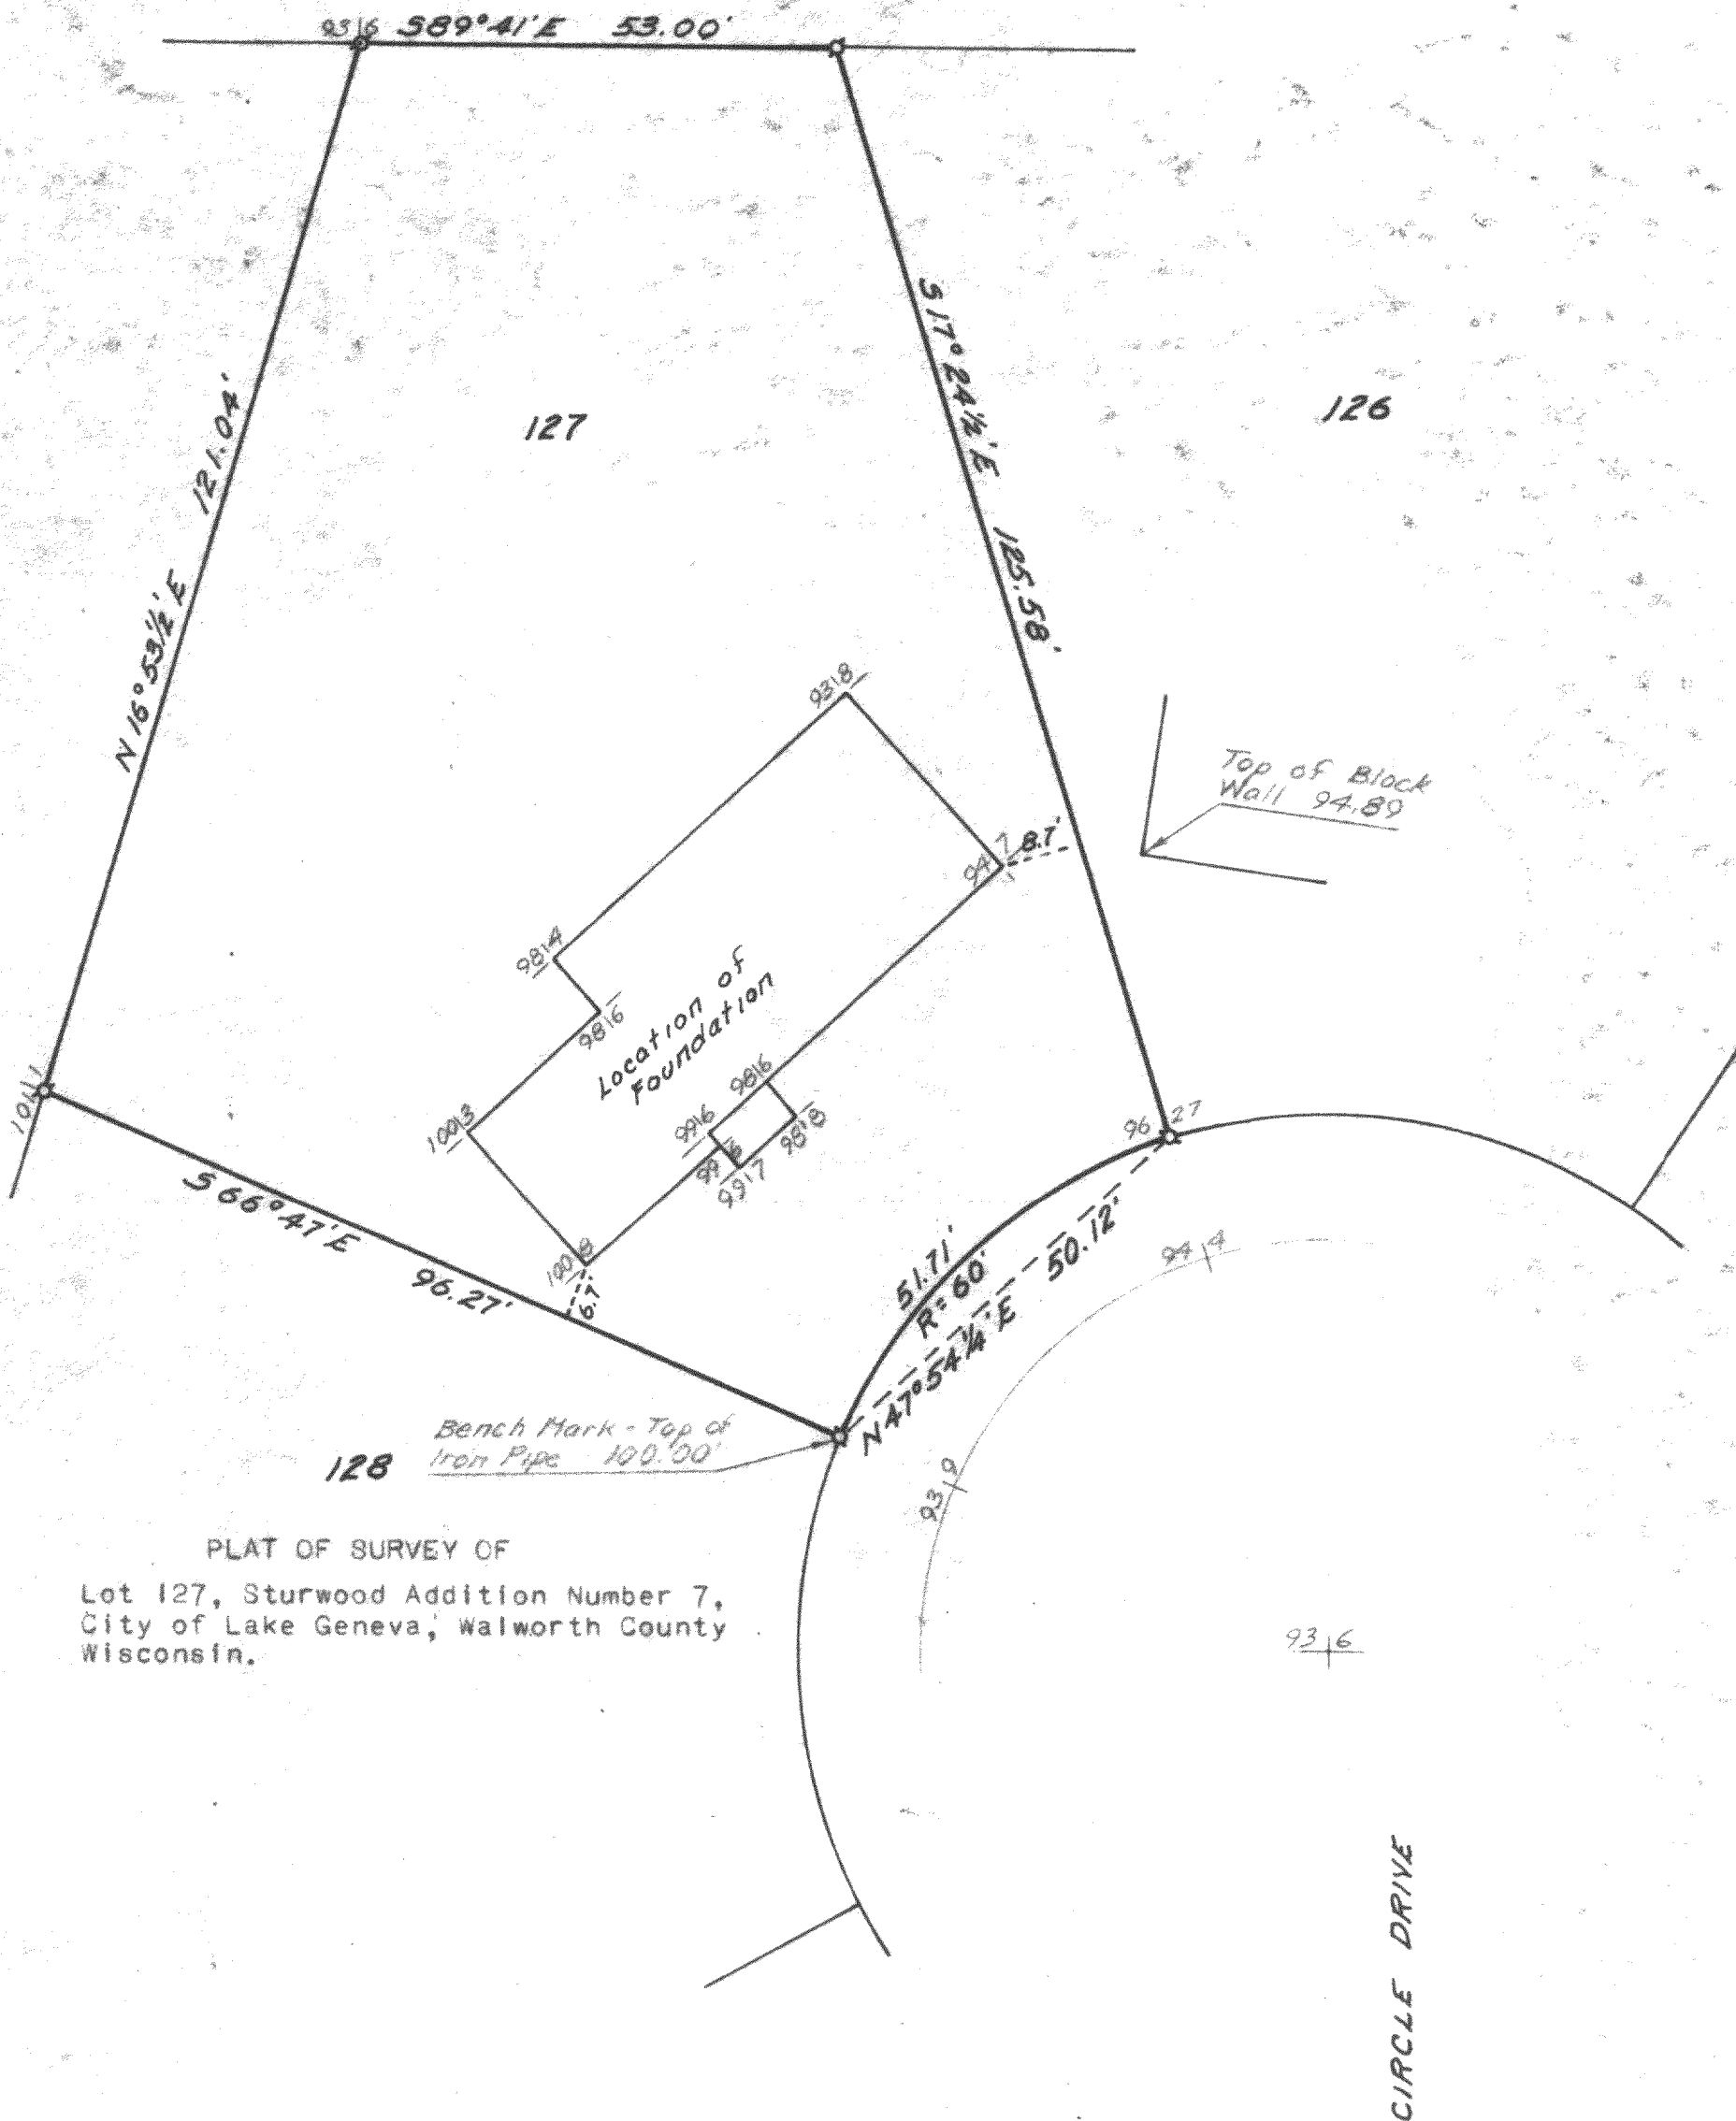

SCALE: 1" = 20'

## LEGEND

- ⊗ - IRON PIPE FOUND
- - IRON PIPE PLACED
- - CONCRETE MONUMENT
- ✕ - SPIKE
- ⊙ - Iron Rod Found



I, HAROLD H. KOLB, DO HEREBY CERTIFY THAT I HAVE  
SURVEYED THE PROPERTY HEREON DESCRIBED ACCORDING  
TO THE OFFICIAL RECORDS, AND THAT THE PLAT HEREON  
IS A CORRECT REPRESENTATION OF THE LOT LINES and  
the principle lines of the building thereon.

*Harold H. Kolb*  
HAROLD H. KOLB

WISCONSIN REGISTERED LAND SURVEYOR, S-187  
DATE February 6, 1969

Revised Mar. 19, 1969

7-299