PREPARED FOR: LAKE GENEVA AREA REALTY 101 BROAD ST LAKE GENEVA, WI.

## PLAT OF SURVEY

- OF -

LOT 15 OF TONY AND JULIA PETERS ADDITION, LOCATED IN SECTION 26, TOWN 2 NORTH, RANGE 17 EAST, CITY OF LAKE GENEVA, WALWORTH COUNTY, WISCONSIN.


PATHFINDER SURVEYING INC. ( formerly ) J.K. SURVEYING INC. P.O BOX 322 LAKE GENEVA, WI. 53147 WWW.PATHFINDERSURVEYING.NET 262-248-8303

STREET CAREY

MARION STREET

KIMPS LAKE GENEVA.

JEPF L VIMP8 & 2436 Wieconsin Registered Land Surveyor ( original if signed in red )

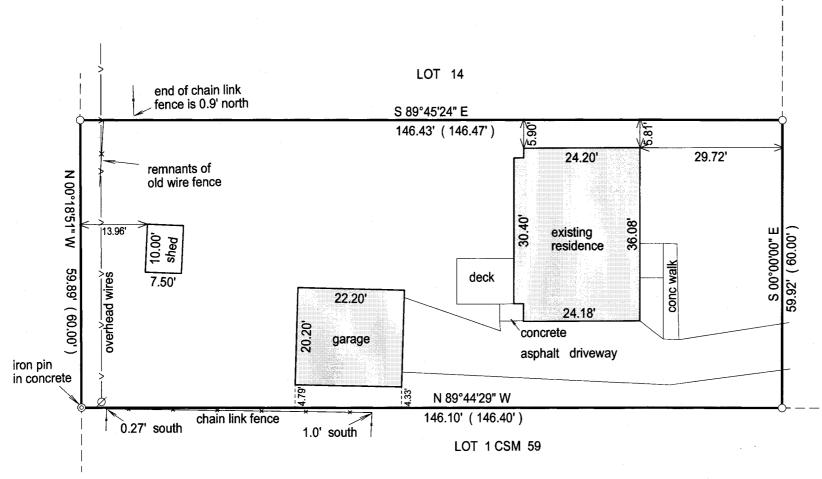

( )= recorded as

□ = found iron bar

= found iron pipe


= set iron pipe

= set iron bar

SCALE 1" = 20'

JOB # 14-71

TAX ID # ZPA 00015

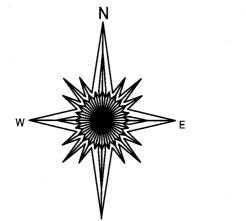

20 BASIS OF BEARING OF THIS PLAT: THE WEST LINE OF CAREY ST WAS ASSUMED TO BEAR SOUTH.

"I hereby certify that I have surveyed the above described property and that the above map is a true representation of its exterior boundary and shows the size and location of all visible structures, apparent easements and encroachments if any."

This survey is made for the present owners of the property, and those who purchase, mortgage, or guarantee the title thereto, within one year from the date hereof.

DATED THIS 5TH DAY OF MAY, 2014.