LAND-MARK SURVEYING

Mark L. Miritz Wisconsin Registered Land Surveyor S-2582 N9330 Knuteson Drive Whitewater, WI 53190 Phone: (262)495-3284 MARKMIRITZ@ LAND-MARKSURVEYING.COM


PLAT OF SURVEY

LOT 12 IN GARRISON GLEN SUBDIVISION, LOCATED IN NORTHEAST 1/4 OF SECTION 1, TOWN 1 NORTH, RANGE 17 EAST, CITY OF LAKE GENEVA, WALWORTH COUNTY, WISCONSIN.

ORDERED BY:
IRENE A. HORODECKI
LEGAL ASSISTANT
OHALLORAN KOSOFF GEITNER & COOK, LLC
EDENS CORPORATE CENTER
650 DUNDEE ROAD, FOURTH FLOOR
NORTHBROOK, IL 60062

GARRISON DRIVE

(60' WIDE)

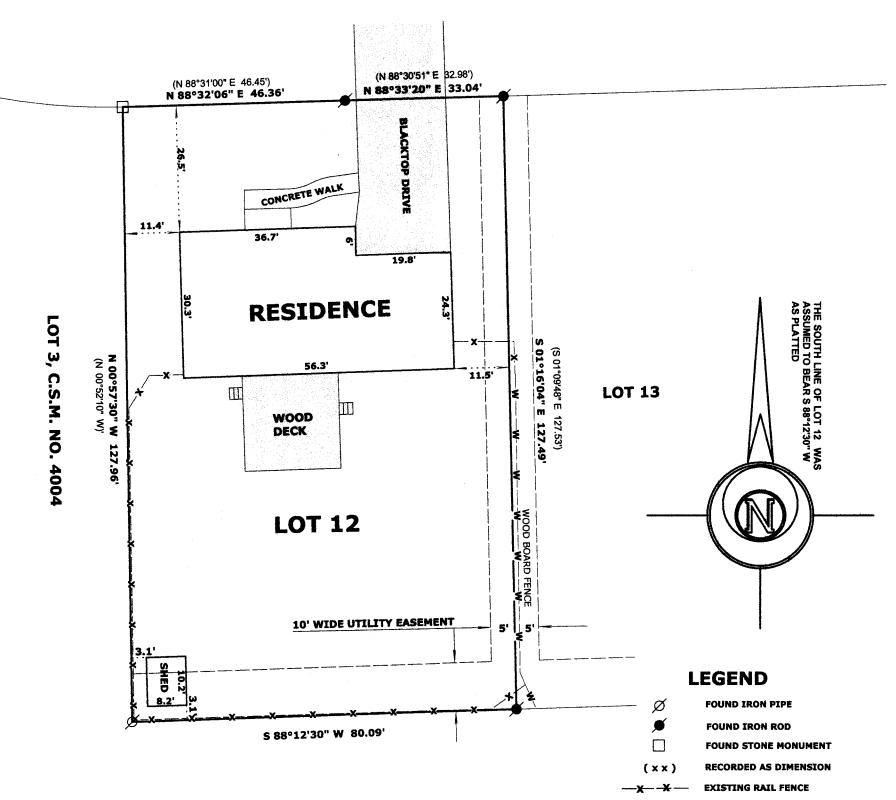





SCALE: 1 INCH = 20 FEET

"I hereby certify that the above described property has been surveyed by me or under my direction and that the above map is a true representation thereof and shows the size and location of the property, its exterior boundaries, the location of all visible structures and dimensions of all principal buildings thereon, boundary fences, apparent easements, roadways and visible encroachments, if any."

"This survey is made for the use of the present owners of the property and also those who purchase mortage or

"This survey is made for the use of the present owners of the property, and also those who purchase, mortgage, or guarantee the title thereto within one year from date hereof."

MARK L. MIRITZ
WISCONSIN REGISTERED
LAND SURVEYOR S-2582

DATE: JULY 29, 2014

JOB NO. 14.712

007 - 3052