


# PLAT OF SURVEY

UNIT 9 MAYTAG ESTATES CONDOMINIUM LOCATED IN PART OF  
SW 1/4 OF THE NE 1/4 AND PART OF THE SE 1/4 OF THE NW 1/4 OF  
SECTION 1, TOWN 1 NORTH, RANGE 17 EAST IN THE  
CITY OF LAKE GENEVA, WALWORTH COUNTY, WISCONSIN

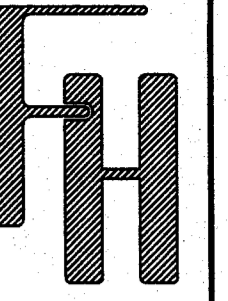


WORK ORDERED BY -  
LOWELL MANAGEMENT  
P.O. BOX 926  
LAKE GENEVA, WI 53147

FARRIS, HANSEN & ASSOCIATES, INC.  
ENGINEERING - ARCHITECTURE - SURVEYING  
7 RIDGWAY COURT P.O. BOX 437  
ELKHORN, WISCONSIN 53121  
OFFICE: (262) 723-2098 FAX: (262) 723-5886


REVISIONS

PROJECT NO.  
8992  
DATE  
04/03/2014  
SHEET NO.  
1 OF 1

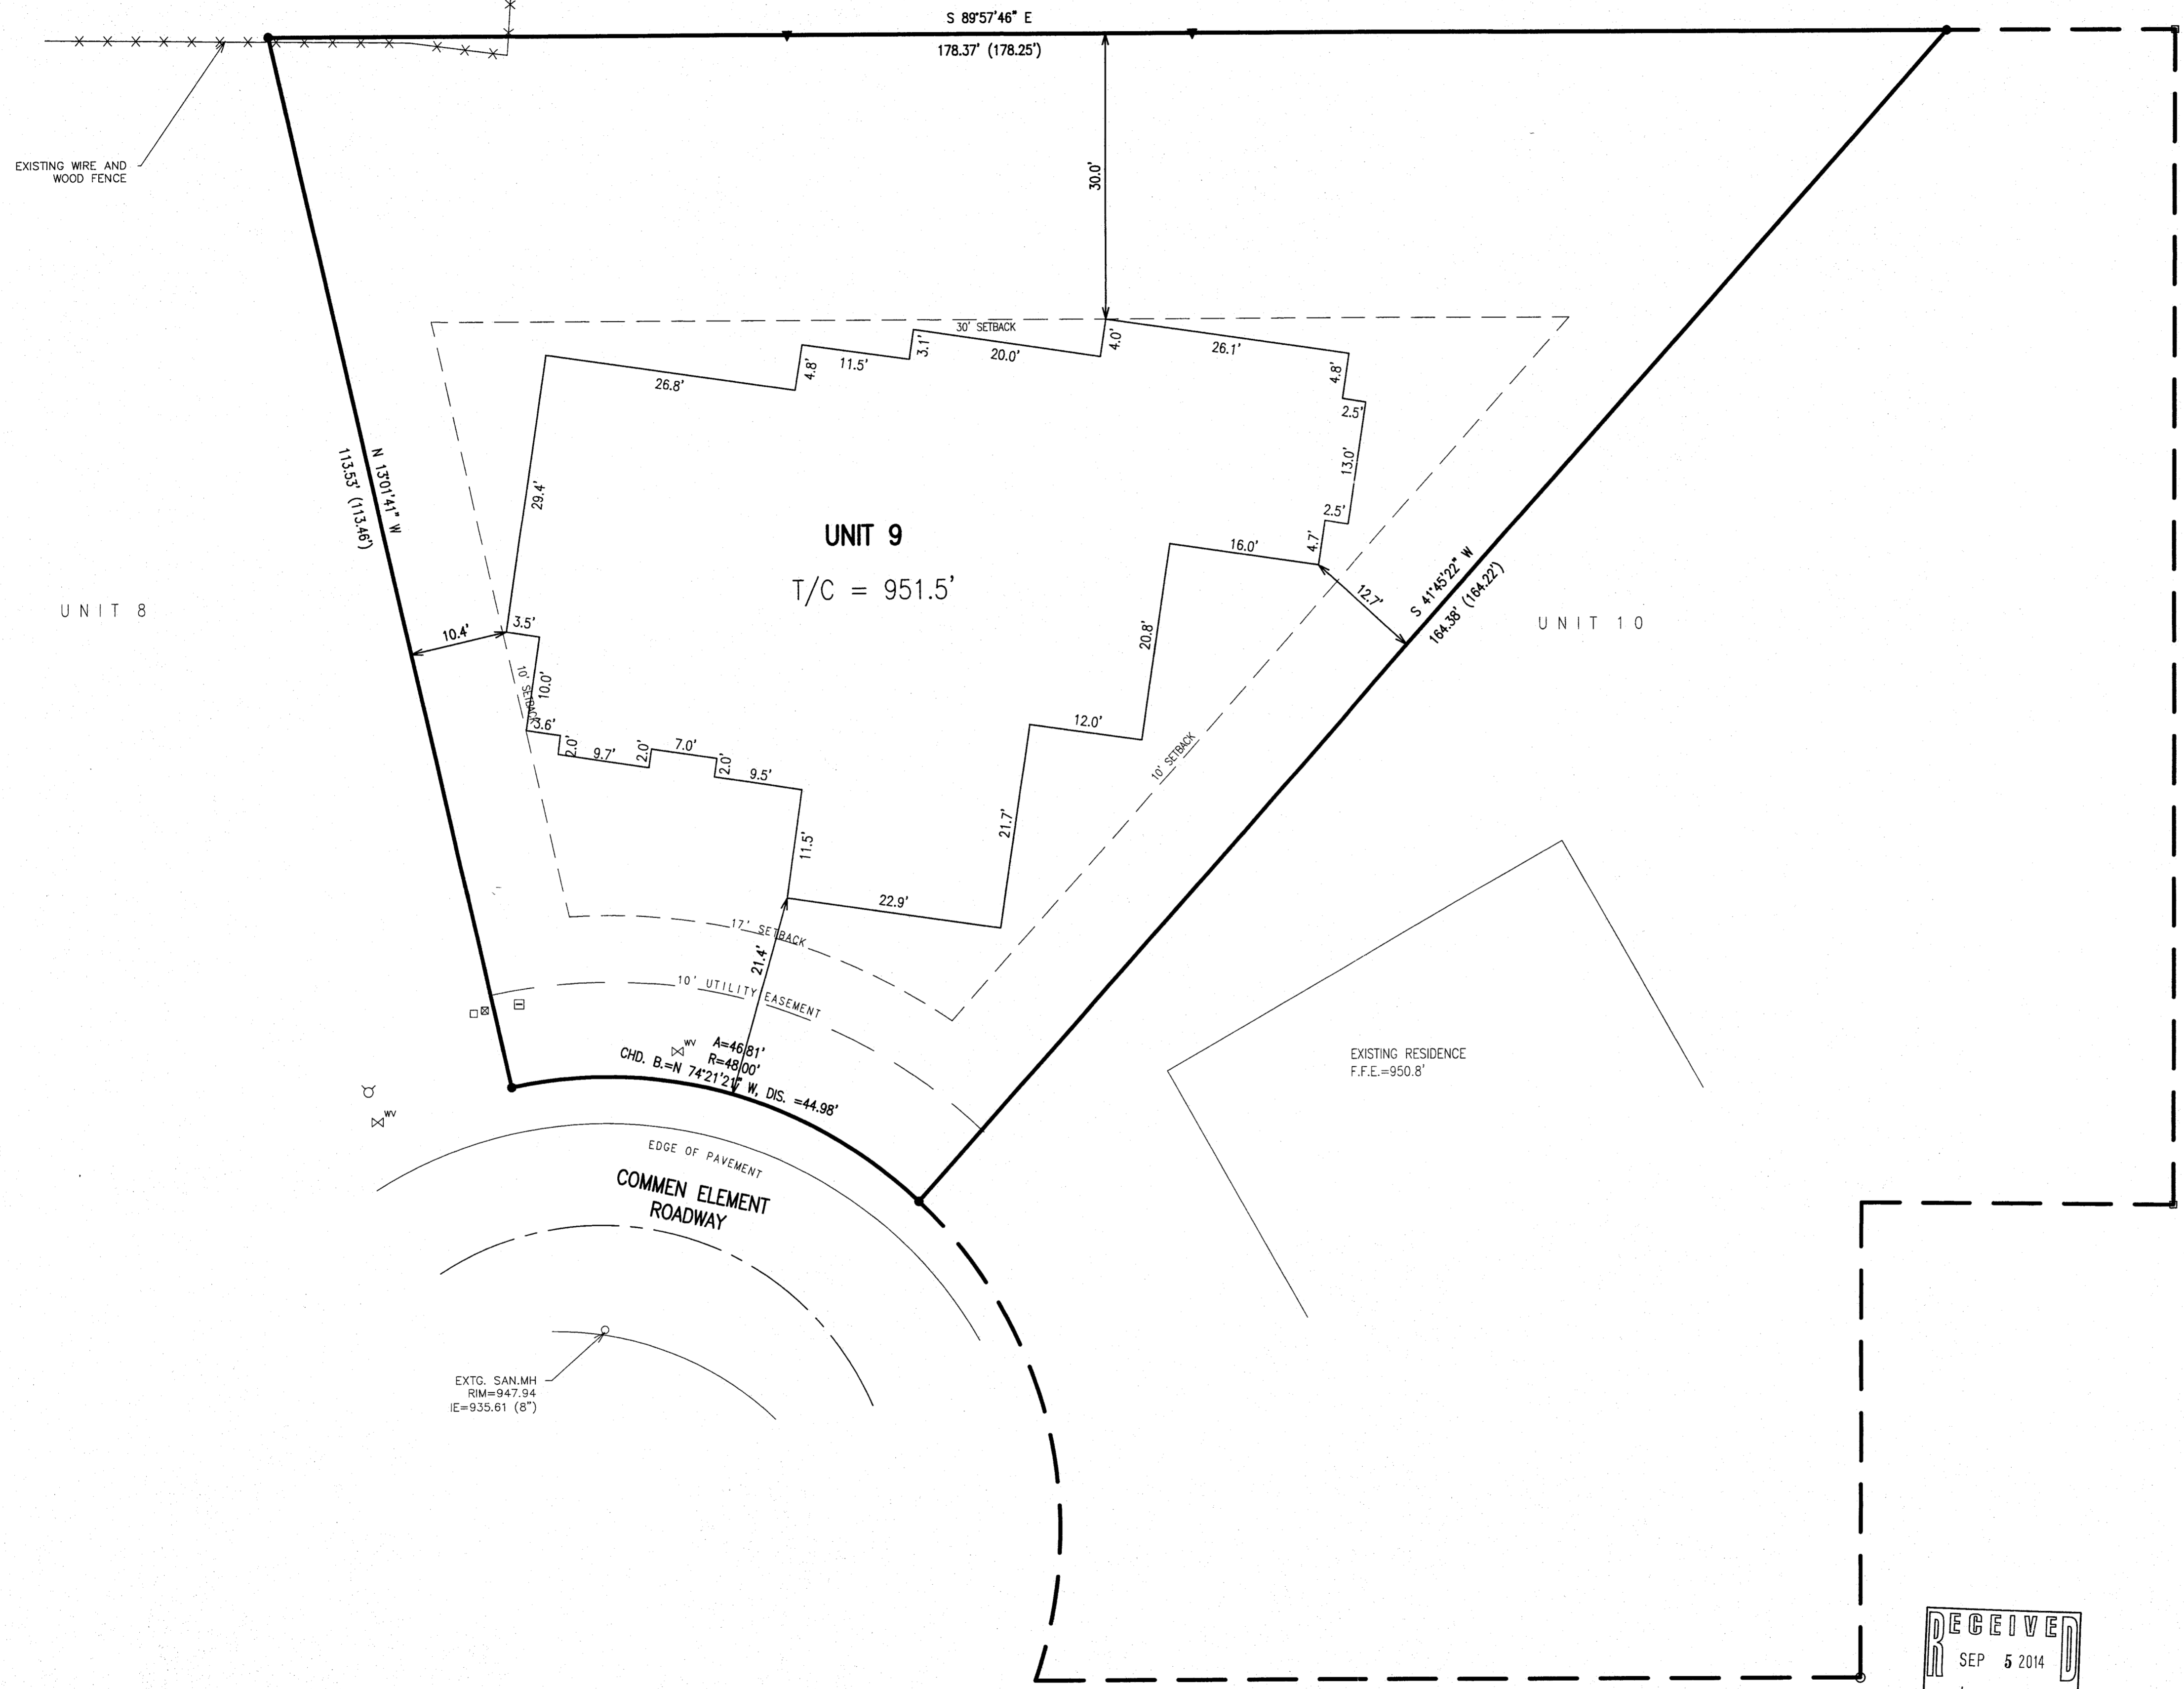

- LEGEND
- = FOUND IRON PIPE STAKE
  - ▲ = SET LATHE ON-LINE
  - = CABLE BOX LOCATED
  - ⊞ = ELECTRIC TRANSFORMER LOCATED
  - ⊞ = TELEPHONE BOX LOCATED
  - ⊞ = HYDRANT LOCATED
  - ⊞ = VALVE LOCATED
  - (XXX) = RECORDED AS


RECEIVED  
SEP 5 2014  
By *Jan*

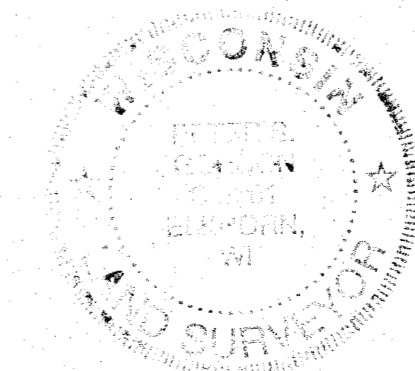

NOTE: COPIES OF THIS MAP TO WHICH THE FOLLOWING CERTIFICATE WILL APPLY SHOW THE SURVEYOR'S ORIGINAL SEAL AND SIGNATURE IN RED INK. COPIES BY ANY OTHER MEANS MAY HAVE ALTERATIONS WHICH DO NOT REPRESENT THE SURVEYOR'S WORK PRODUCT.

I HEREBY CERTIFY THAT THE ABOVE DESCRIBED PROPERTY HAS BEEN SURVEYED UNDER MY DIRECTION AND THAT THE ABOVE MAP IS A TRUE REPRESENTATION THEREOF AND SHOWS THE SIZE AND LOCATION OF THE PROPERTY AND ITS EXTERIOR BOUNDARIES. THIS SURVEY IS MADE FOR THE USE OF THE PRESENT OWNERS OF THE PROPERTY, AND ALSO THOSE WHO PURCHASE, MORTGAGE, OR GUARANTEE THE TITLE THERETO WITHIN ONE YEAR FROM THE DATE HEREOF.

DATED: 04/03/2014  
04/29/2014 - REVISED TO SHOW ADDITIONAL TOPO  
07/10/2014 - REVISED TO SHOW SIZE AND LOCATION OF ASBUILT FOUNDATION  
*Peter S. Gordon*  
PETER S. GORDON R.L.S. 2101

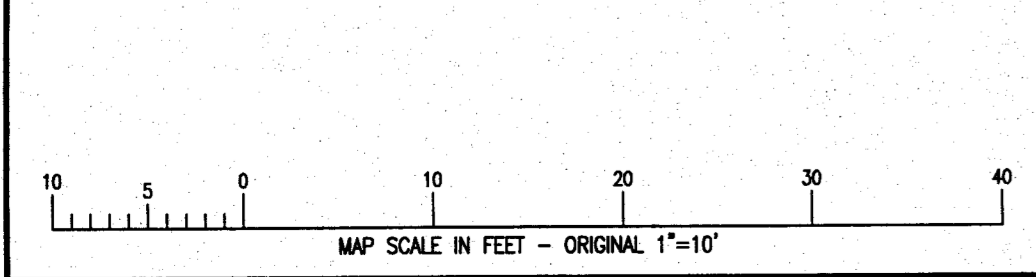

JUL 10 2014

X:\PROJECTS\8992\ACAD\8992.dwg