


PLAT OF SURVEY

- OF -


LOT 37 PEARSON SUBDIVISION, LOCATED IN SECTION 35, TOWN 2 NORTH, RANGE 17 EAST OF THE FOURTH PRINCIPAL MERIDIAN, CITY OF LAKE GENEVA, COUNTY OF WALWORTH AND STATE OF WISCONSIN.

PATHFINDER SURVEYING INC.
(formerly)
J.K. SURVEYING INC.
P.O BOX 322
LAKE GENEVA, WI. 53147
WWW.PATHFINDERSURVEYING.NET
262-248-8303


PREPARED FOR:
LAKE GENEVA AREA REALTY
101 BROAD ST
LAKE GENEVA, WI.

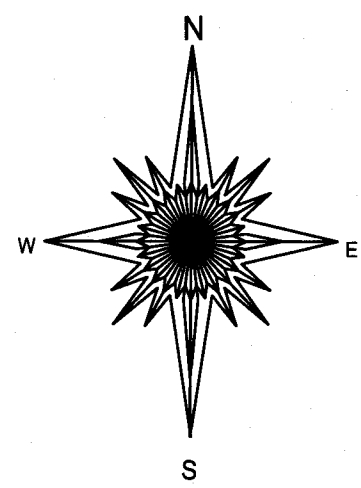

PEARSON DRIVE

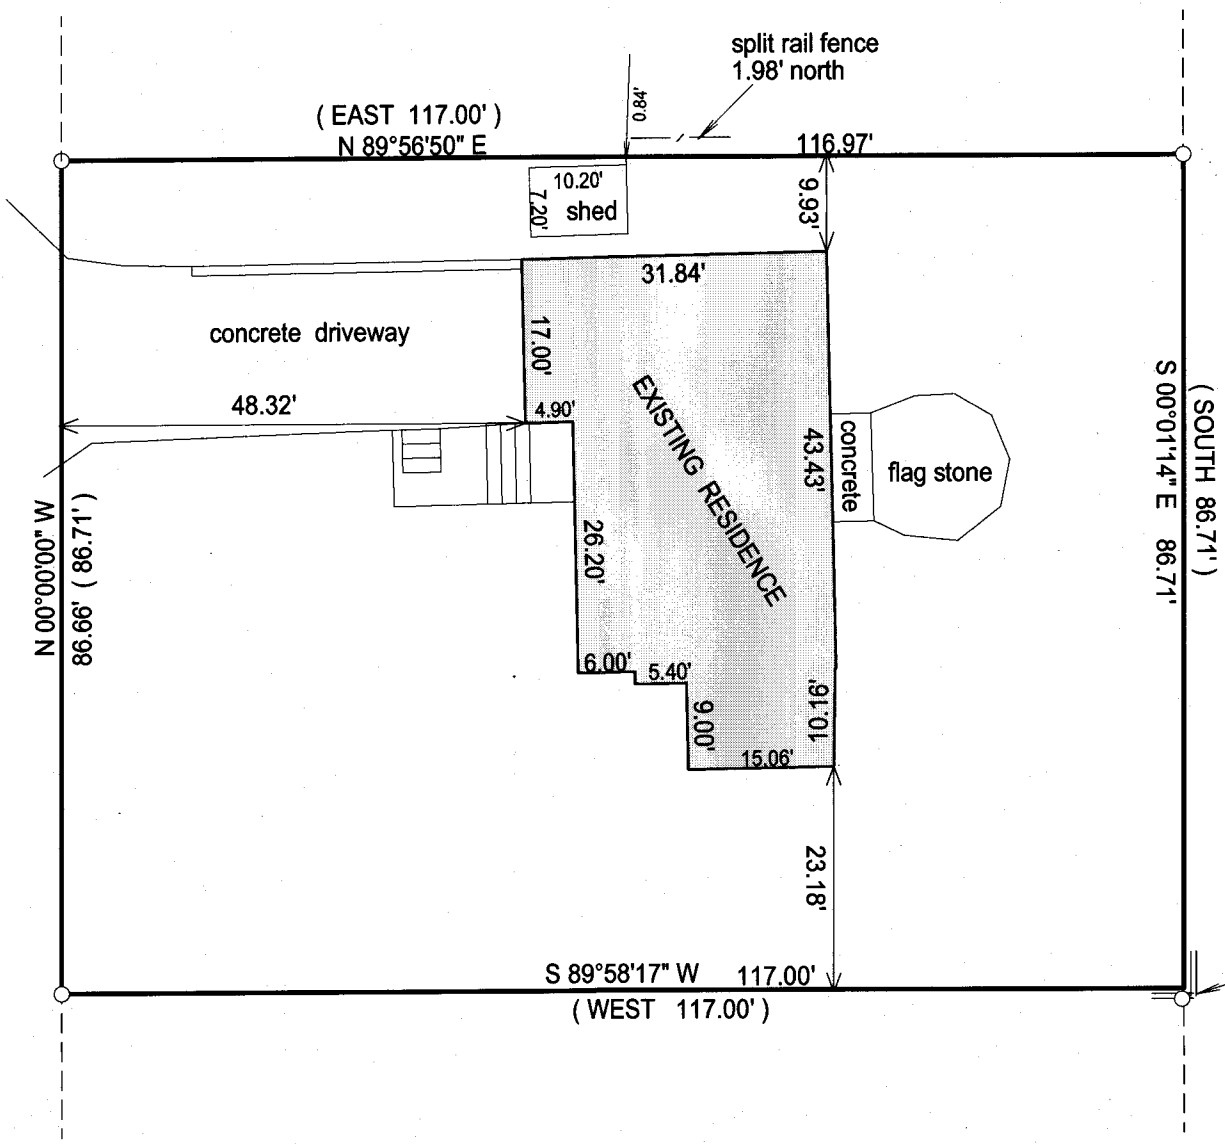

found iron pipe
on the southerly
edge of a block
retaining wall
wall is leaning southerly
iron was located as close as possible

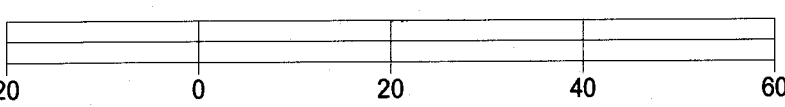

BASIS OF BEARING OF THIS PLAT: THE EAST LINE OF PEARSON DRIVE WAS ASSUMED TO BEAR NORTH.

- () = RECORDED AS
- = FOUND IRON BAR
- = FOUND IRON PIPE
- = SET IRON BAR
- = SET IRON PIPE



SCALE: 1" = 20'

JOB #: 14-115

TAX ID #: ZP 00037

"I hereby certify that I have surveyed the above described property and that the above map, to the best of my knowledge and belief, is a true representation thereof and shows the size and location of all visible structures, apparent easements and encroachments if any."
This survey is made for the present owners of the property, and those who purchase, mortgage, or guarantee the title thereto, within one year from the date hereof.

DATED THIS 9TH DAY OF JUNE, 2014.

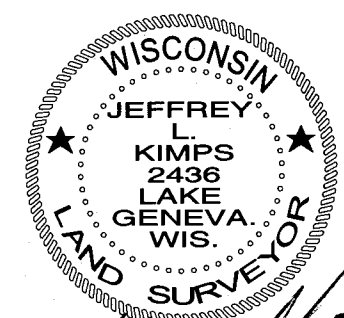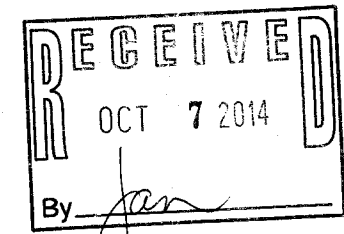

JEFFREY L. KIMPS S-2436
Wisconsin Registered Land Surveyor
(original if signed in red)

ZP -37

007-3078