


PLAT OF SURVEY

Lot 3 of Certified Survey No. 563, according to the plat thereof recorded March 29, 1976 in Volume 3 of Certified Surveys on page 7 as Document No. 01689. Said land being in the City of Lake Geneva, Walworth, Wisconsin.

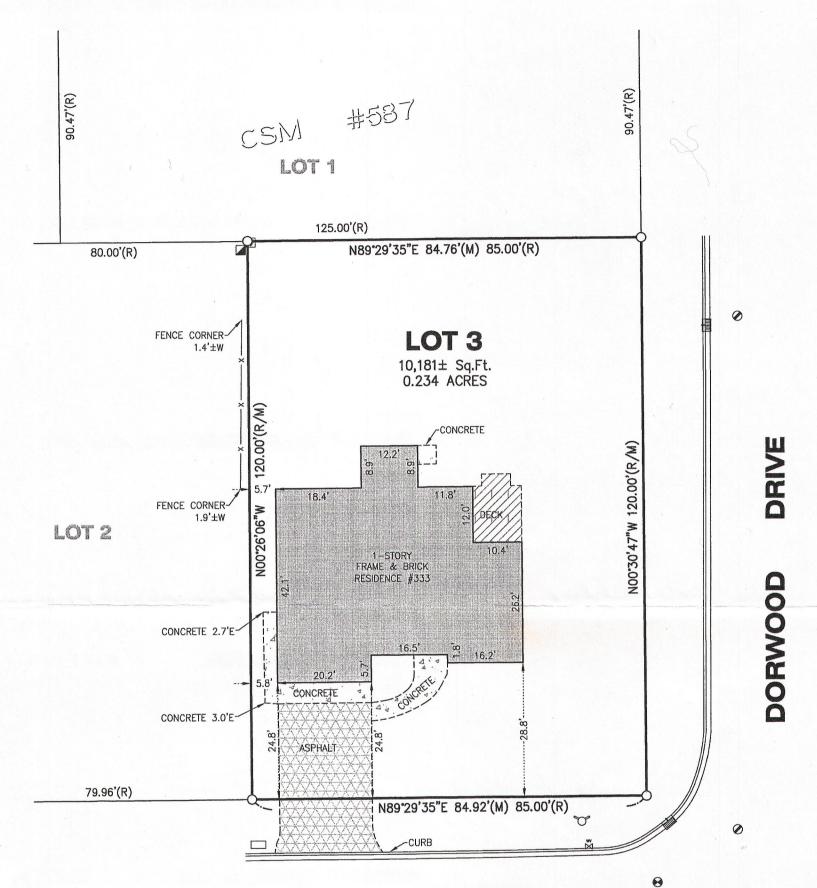

EUGENE DRIVI

| LEGEND | |
|------------|-----------------|
| (a) | CATCH BASIN |
| | CURB INLET |
| | ELECTRIC RISER |
| o | FIRE HYDRANT |
| 0 | FOUND IRON PIPE |
| | MAIL BOX |
| 0 | MANHOLE |
| V | CABLE TV RISER |
| 0 | VALVE VAULT |
| × | WATER VALVE |
| | |

Easements shown on a Recorded Subdivision
Plat are shown hereon unless the description
ordered to be surveyed contains a proper
description of the required building lines or
easements.

* No distance should be assumed by scaling.


No underground improvements have been located unless shown and noted.
 No representation as to ownership, use, or

NOTE: Only those Building Line Restrictions or

possession should be hereon implied.

* This Survey and Plat of Survey are void without original embossed or colored seal and signature affixed.

Compare your description and site markings with this plat and AT ONCE report any discrepancies which you may find.

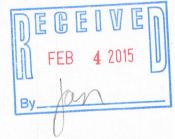

STATE OF ILLINOIS)
COUNTY OF MCHENRY)

In my professional opinion and based on my observations, I hereby certify that the above described property has been surveyed under my direction and that the above map is a true representation thereof and shows the size and location of all visible structures, and dimensions of all principle buildings thereon, boundary fences, apparent easements, roadways, and visible encroachments, if any. This survey is made for the use of the present owners of the property, and also those who purchase, mortgage, or guarantee the title thereto within one year from the date hereof.

Dated at Woodstock,
McHenry County, Illinois 6/28 A.D., 20 13.

Vanderstappen Surveying & Engineering, Inc. Design Firm No. 184-002792

By: Misconsin Registered Land Surveyor No. S1777

Y:\PLATS\2013\0200-0399\130362_V-130362\130362-LSS.dwg-Layout1-6/28/2013 1:34 PM