PREPARED FOR LINCOLN HOLDING GROUP

PLAT OF SURVEY

- OF -

LOT 7, BLOCK 1 OF THE ORIGINAL PLAT OF THE VILLAGE (NOW CITY) OF LAKE GENEVA, ACCORDING TO THE RECORD PLAT THEREOF, WALWORTH COUNTY, WISCONSIN.

PATHFINDER SURVEYING INC.

(formerly)


J.K. SURVEYING INC.

P.O BOX 322

LAKE GENEVA, WI. 53147

WWW.PATHFINDERSURVEYING.NET

262-248-8303

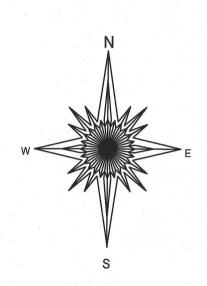

()= recorded as

☐ = found iron bar

= found iron pipe


= set iron pipe

= set iron bar

SCALE 1" = 20'

JOB # 15-81

TAX ID # ZOP00012

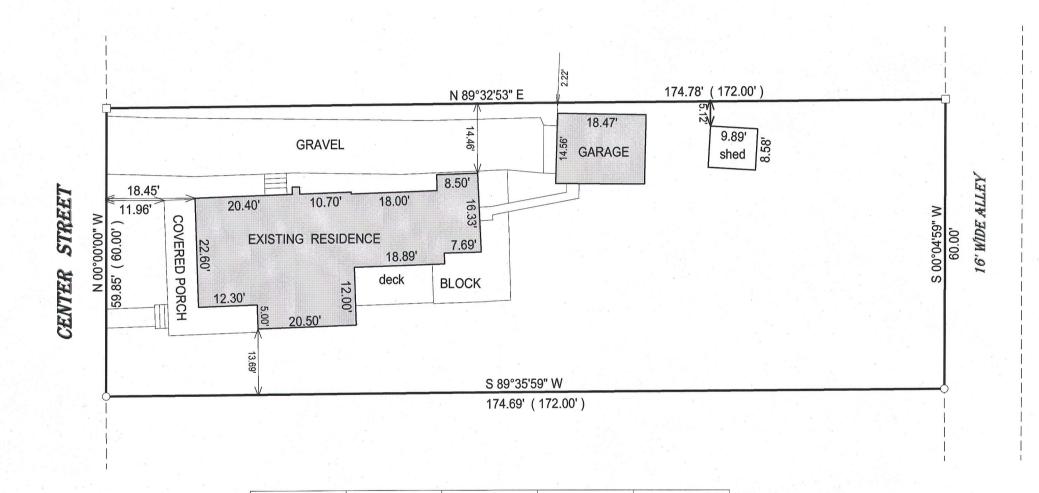

0 20 40 60

BASIS OD BEARING OF THIS PLAT: THE EAST LINE OF CENTER ST. WAS ASSUMED TO BEAR NORTH.

"I hereby certify that I have surveyed the above described property and that the above map is a true representation of its exterior boundary and shows the size and location of all visible structures, apparent easements and encroachments if any."

This survey is made for the present owners of the property, and those who purchase, mortgage, or guarantee the title thereto, within one year from the date hereof.



JEFFREY L KIMPS S-2436 Wisconsin Registered Land Surveyor (original if signed in red)

S-2436

DATED THIS 7TH DAY OF APRIL, 20105.