


LAND-MARK SURVEYING
Mark L. Miritz
 Wisconsin Professional Land Surveyor S-2582

N9330 Knuteson Drive
 Whitewater, WI 53190
 Phone: (262)495-3284
 MARKMIRITZ@
 LAND-MARKSURVEYING.COM

PLAT OF SURVEY

LOT 41, TOWNLINE TRAILS SUBDIVISION, LOCATED IN
 PART OF THE NORTHEAST 1/4 OF THE NORTHWEST 1/4
 AND THE SOUTHEAST 1/4 OF THE NORTHWEST 1/4 OF
 SECTION 6, ALL IN TOWN 1 NORTH, RANGE 18 EAST,
 CITY OF LAKE GENEVA, WALWORTH COUNTY, WISCONSIN


ORDERED BY: **BASSO BUILDERS, INC.**
 405 SKYLINE ROAD
 LAKE GENEVA, WI 53147

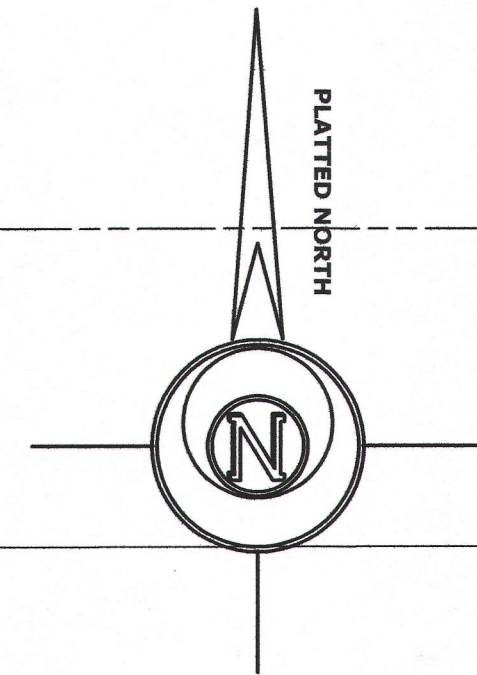

TOWNLINE ROAD

CUMBERLAND TRAIL

33'
 40'
 60' WIDE
 (S 00°08'05" E 90.04')
 (S 00°08'05" E 90.00')

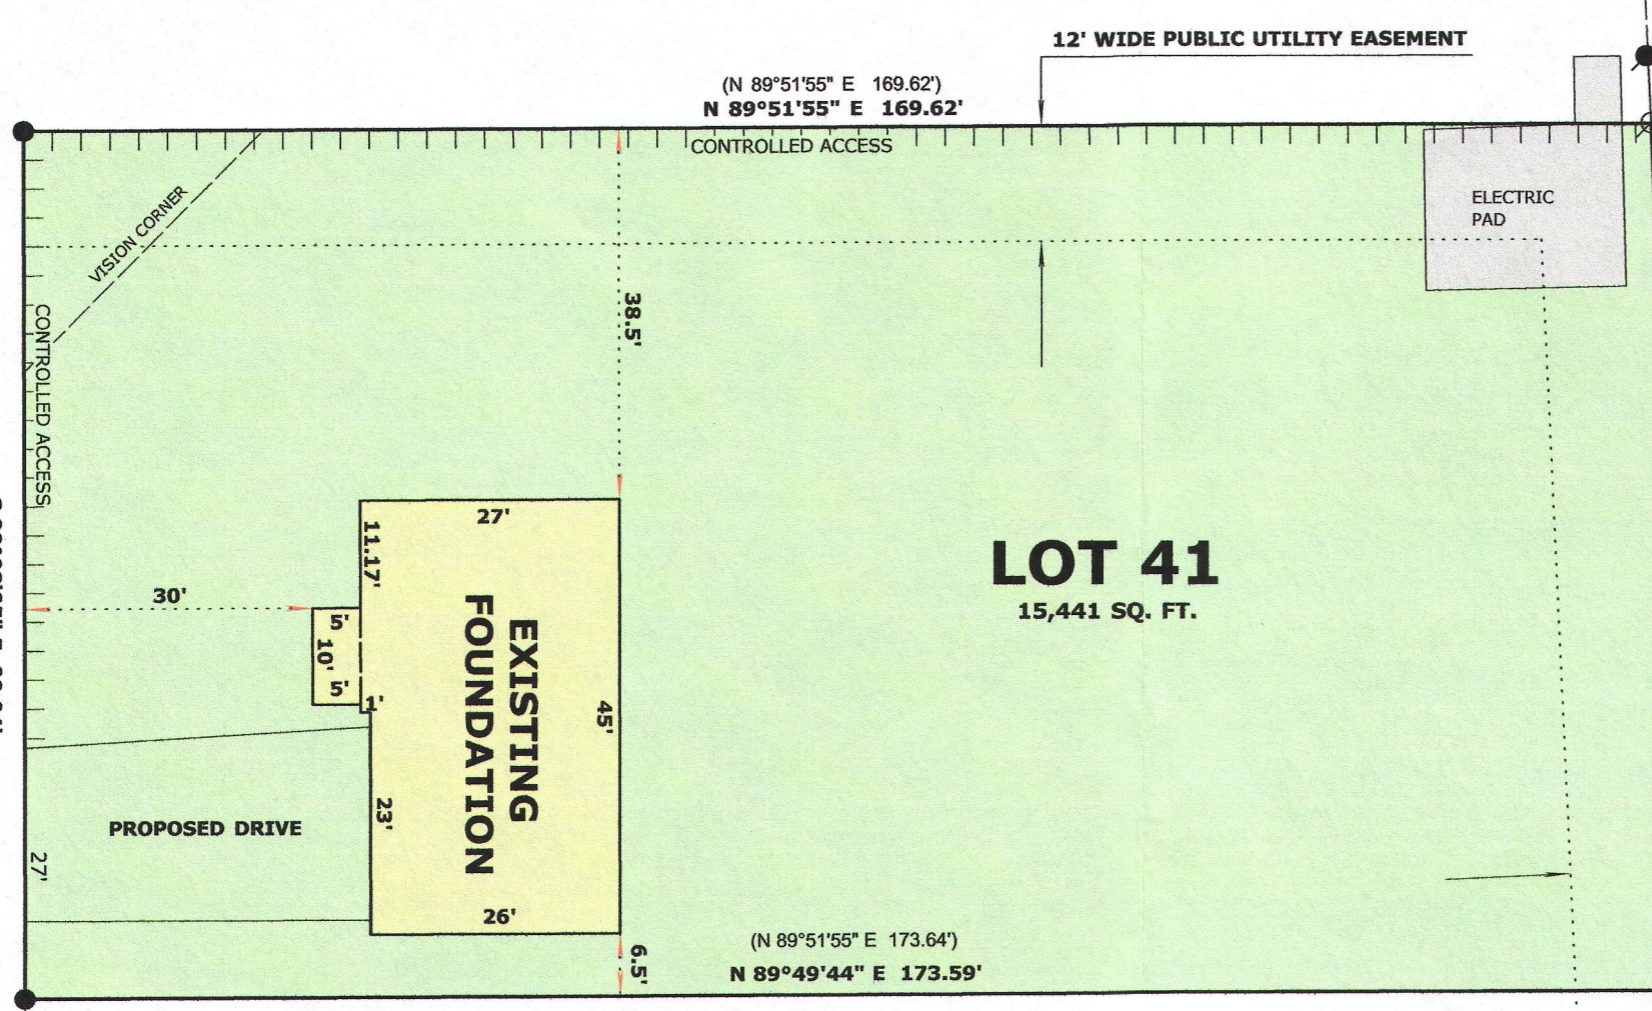

RECEIVED
 OCT 2 2015
 By *Jan*



LEGEND

- FOUND IRON PIPE
- SET IRON ROD, 18" LONG, WEIGHING 1.5 LBS./LINEAL FT., 3/4" DIA.
- (x x)** RECORDED AS DIMENSION

SCALE: 1 INCH = 20 FEET

"I hereby certify that the above described property has been surveyed by me or under my direction and that the above map is a true representation thereof and shows the size and location of the property, its exterior boundaries, the location of all visible structures and dimensions of all principal buildings thereon, boundary fences, apparent easements, roadways and visible encroachments, if any."
 "This survey is made for the use of the present owners of the property, and also those who purchase, mortgage, or guarantee the title thereto within one year from date hereof."

Mark L. Miritz
MARK L. MIRITZ
 WISCONSIN PROFESSIONAL
 LAND SURVEYOR S-2582

REVISED AUGUST 26, 2015
 TO SHOW FOUNDATION
 "AS BUILT"

DATE: APRIL 30, 2015 JOB NO. 15.409

ZTT-41 007-3182