

#41-70

O-INDICATES IRON PIPE

NAIL

182.73'

182.73' EAST

22'

89'

26'

49'

85'

15'

7'

20'

11'

10'

8'

8'

139.31'

139.31' SOUTH

98'

80.15'

80.15' WEST

TOWNLINE RD.

POINT OF BEGINNING


25'

33.2'

LOGAN AVE.

173.00' N 36°22' W

CTH "H"

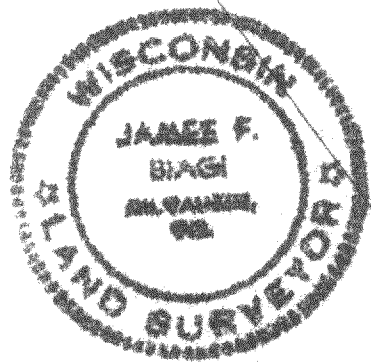

DESCRIPTION: Commencing at the SE corner of Section 36, T.2N., R.17E., City of Lake Geneva, Walworth County, Wisconsin; thence West along the South line of said section 163.00 feet, thence North 25 feet to the point of beginning of the lands hereinafter described, to wit; thence West along the north line of Townline Road 80.15 feet, thence N. 36°22' W. along the east line of Logan Avenue 173.00 feet, thence East 182.73 feet, thence South 139.31 feet to the point of beginning.

CERTIFICATE: I, James F. Biagi, surveyor, do hereby certify that I surveyed the lands hereon described, and that the improvements are as shown.

March 9, 1970

James F. Biagi R.L.S. 272

OF-399

7-327