
## HAROLD H. KOLB

REGISTERED PROFESSIONAL LAND SURVEYOR LAKE GENEVA. WISCONSIN

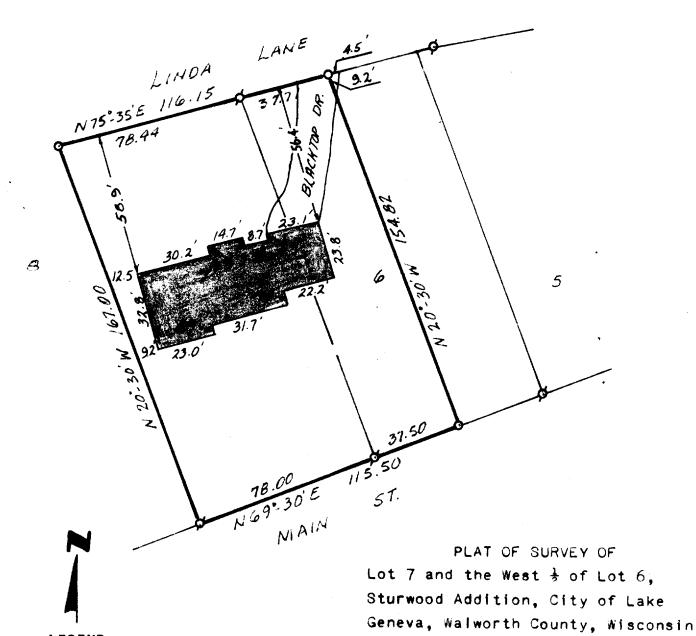

## LEGEND

# - IRON PIPE FOUND

O - IRON PIPE PLACED

- CONCRETE MONUMENT

X - SPIKE

50016 /"= 40'

HAROLD H.
KOLB
S-187
LAKE GENEVA.
WIS.
OSURVERINGE

I, HAROLD H. KOLB, DO HEREBY CERTIFY THAT I HAVE

I, HAROLD H. KOLB, DO HEREBY CERTIFY THAT I HAVE SURVEYED THE PROPERTY HEREON DESCRIBED ACCORDING TO THE OFFICIAL RECORDS, AND THAT THE PLAT HEREON IS A CORRECT REPRESENTATION OF THE LOT LINES and the principle lines of the building thereon.

Harold H. Kol

WISCONSIN REGISTERED LAND SURVEYOR, S-187 DATE NIGT. 16, 1968

Revised: Nov. 9, 1970

7-328