


#88⁶-69

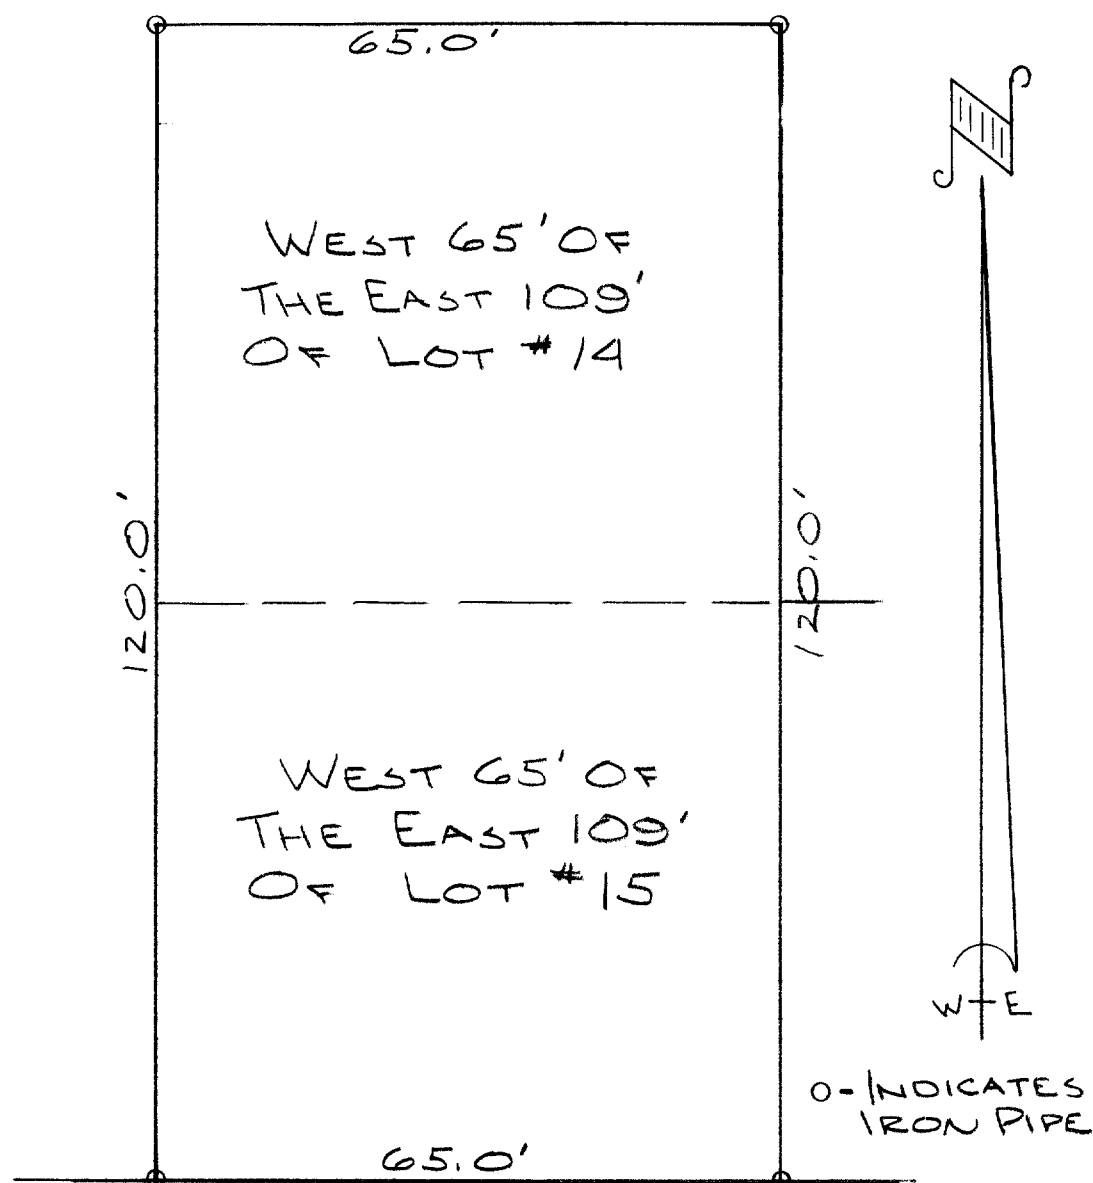


DODGE ST.

DESCRIPTION: The West 65.00 feet of the East 109.00 feet of Lots 14 and 15 of Block 3 of Goodsell's Subdivision of Block 3 of the Villiage, now City, of Lake Geneva, Walworth County, Wisconsin. Also a right of way 10.00 feet wide off of the North side of the East 44.00 feet of said Lots 14 and 15.

CERTIFICATE: I, James F. Biagi, surveyor, do hereby certify that I have surveyed the property hereon described.

June 25, 1969.

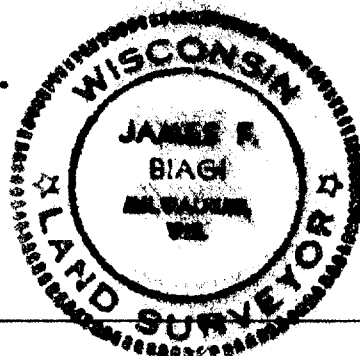

James F. Biagi
James F. Biagi, R.L.S. 272