PREPARED FOR: TRICIA FORBECK KEEFE REAL ESTATE LAKE GENEVA, WI.

= set iron pipe = set iron bar

SCALE 1" = 20'

JOB # 16-250

TAX ID # ZA317900001

PLAT OF SURVEY

- OF -

PATHFINDER SURVEYING INC.

(formerly)

J.K. SURVEYING INC.

P.O BOX 322

LAKE GENEVA, WI. 53147


WWW.PATHFINDERSURVEYING.NET
262-248-8303

JEFFREY L KIMPS S - 2436

(original if signed in red)

Wiscopsin Professional Land Surveyor

LOT 1 OF CERTIFIED SURVEY MAP No. 3179, RECORDED IN VOLUME 17 OF CERTIFIED SURVEYS, ON PAGE 243 AS DOCUMENT No. 433826 AND BEING A REDIVISION OF LOT 15 AND PARTS OF LOTS 14 AND 16, BLOCK 31 OF LAKE GENEVA MANOR TRACT No. 17, ACCORDING TO THE RECORD PLAT THEREOF. SAID LAND BEING IN THE CITY OF LAKE GENEVA, COUNTY OF WALWORTH AND STATE OF WISCONSIN.

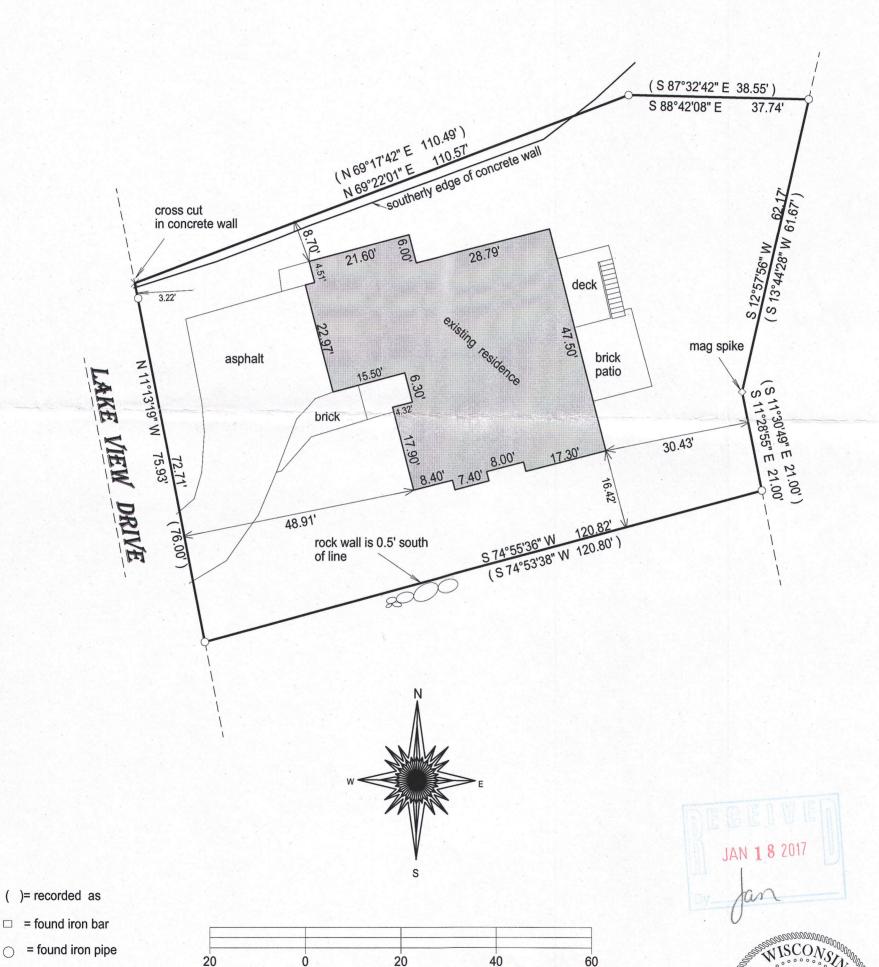

BASIS OF BEARING OF THIS PLAT: THE CERTIFIED SURVEY OF RECORD.

I hereby certify that I have surveyed the above- described property and the above map is a is a true representation thereof and shows the size and

This survey is made for the present owners of the property, and those who purchase, mortgage, or guarantee the title thereto, within one year from

DATED THIS 23RD, DAY OF AUGUST, 2016.

location of the property, its exterior boundaries, the location and dimensions of all structures thereon, fences, apparant easements and

roadways and visible encroachments if any.

the date hereof.