PREPARED FOR MARTHA CUCCO @PROPERTIES 800 W. MAIN ST LAKE GENEVA, WI. 53147

PLAT OF SURVEY

- OF -

THE WEST 15 FEET OF LOT 3 AND LOT 4, BLOCK 25, ORIGINAL PLAT OF THE VILLAGE (NOW CITY) OF LAKE GENEVA, COUNTY OF WALWORTH AND STATE OF WISCONSIN.

PATHFINDER SURVEYING INC.

(formerly)


J.K. SURVEYING INC.

P.O BOX 322


LAKE GENEVA, WI. 53147

WWW.PATHFINDERSURVEYING.NET
262-248-8303

GENEVA STREET

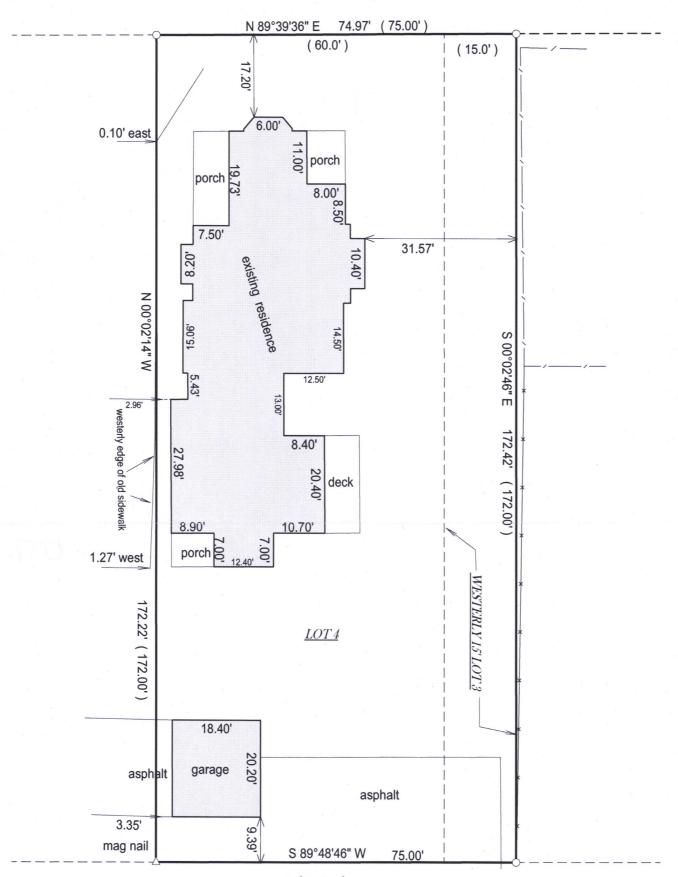

16' WIDE ALLEY

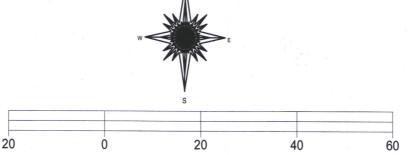


BASIS OF BEARING OF THIS PLAT: THE US STATE PLANE COORDINATE SYSTEM SOUTH ZONE. NAD 83 (WISCORS)

I hereby certify that I have surveyed the above-described property and the above map is a is a true representation thereof and shows the size and location of the property, its exterior boundaries, the location and dimensions of all structures thereon, fences, apparant easements and roadways and visible encroachments if any.

This survey is made for the present owners of the property, and those who purchase, mortgage, or guarantee the title thereto, within one year from the date hereof.

DATED THIS 19TH DAY FO NOVEMBER, 2016.



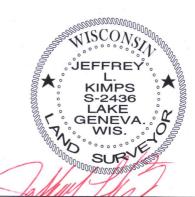

JEFFREY L KIMPS S - 2436 Wisconsin Professional Land Surveyor (original if signed in red)

TAX ID # ZOP 00235

()= recorded as

 \Box = found iron bar

= found iron pipe

= set iron pipe

= set iron bar

SCALE 1" = 20'

JOB # 16-366