PLAT OF SURVEY

- OF -

PATHFINDER SURVEYING INC.

(formerly)


J.K. SURVEYING INC.

P.O BOX 322

LAKE GENEVA, WI. 53147

WWW.PATHFINDERSURVEYING.NET
262-248-8303

LOT 1 OF WALWORTH COUNTY CERTIFIED SURVEY MAP No. 4643, RECORDED IN VOLUME 30 OF CERTIFIED SURVEYS ON PAGE 276 AT THE WALWORTH COUNTY REGISTER OF DEEDS, LOCATED IN THE SW 1/4 OF THE NW 1/4 OF SECTION 36, TOWN 2 NORTH, RANGE 17 EAST, CITY OF LAKE GENEVA, WALWORTH COUNTY, WISCONSIN.

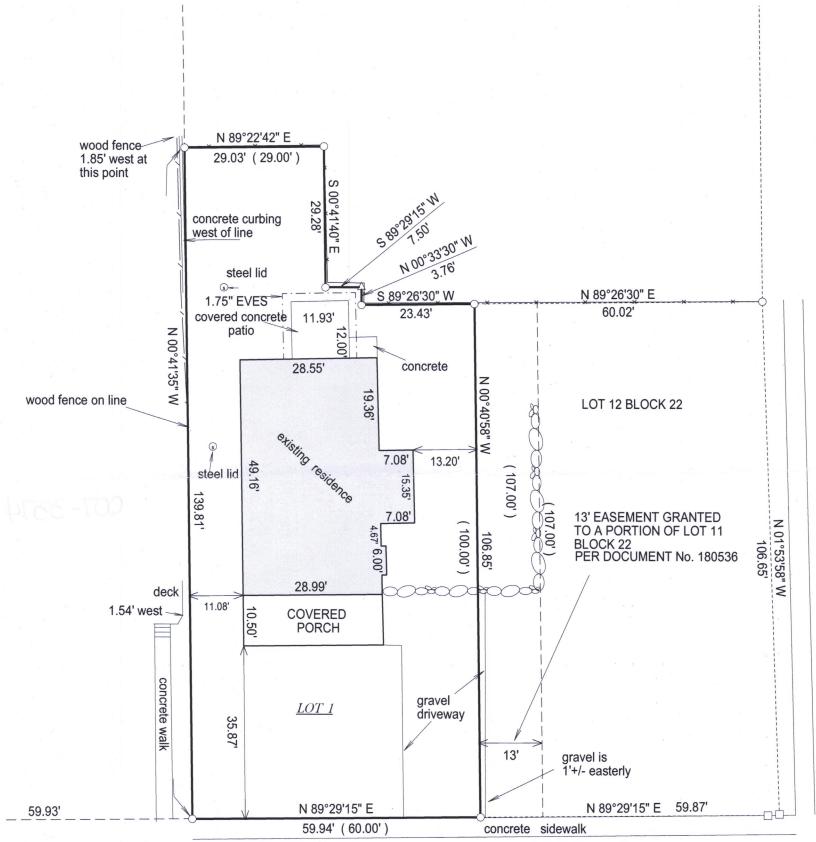


MAIN STREET
(A.K.A. S.T.H. "50")
WIDTH VARIES

- \triangle = mag hub
- = found concrete monument with brass cap
- = found iron bar
- = found iron pipe
- = set iron pipe
- = set iron bar
- SCALE 1" = 20'

JOB # 17-09

TAX ID # ZA464300001

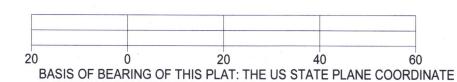

SYSTEM SOUTH ZONE NAD 83. WISCORS.


"I hereby certify that I have surveyed the above described property and that the above map is a true representation thereof and shows the size and location of all visible structures, apparent easements and encroachments

if any."

This survey is made for the present owners of the property, and those who purchase, mortgage, or guarantee the title thereto, within one year from the date hereof.

DATED THIS 23RD DAY OF JANUARY, 2017.



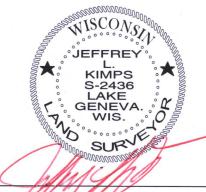

JEFFREY L KIMPS S - 2436 Wisconsin Professional Land Surveyor (original if signed in red)

007-3374