PREPARED FOR:

LAKE GENEVA AREA REALTY

101 BROAD ST

LAKE GENEVA, WI.

## PLAT OF SURVEY

- OF -

ALL OF LOT 10 AND THE WEST 40 FEET OF THE SOUTH 112 FEET OF LOT 11, BLOCK 10, OF THE PLAT OF GENEVA, NOW CITY OF LAKE GENEVA, AND BEING SOMETIMES KNOWN AS THE ORIGINAL PLAT OF THE VILLAGE, NOW CITY OF LAKE GENEVA, WALWORTH COUNTY, WISCONSIN.

PATHFINDER SURVEYING INC.

(formerly)

J.K. SURVEYING INC.


P.O BOX 322

LAKE GENEVA, WI. 53147

WWW.PATHFINDERSURVEYING.NET

262-248-8303

## ALLEY

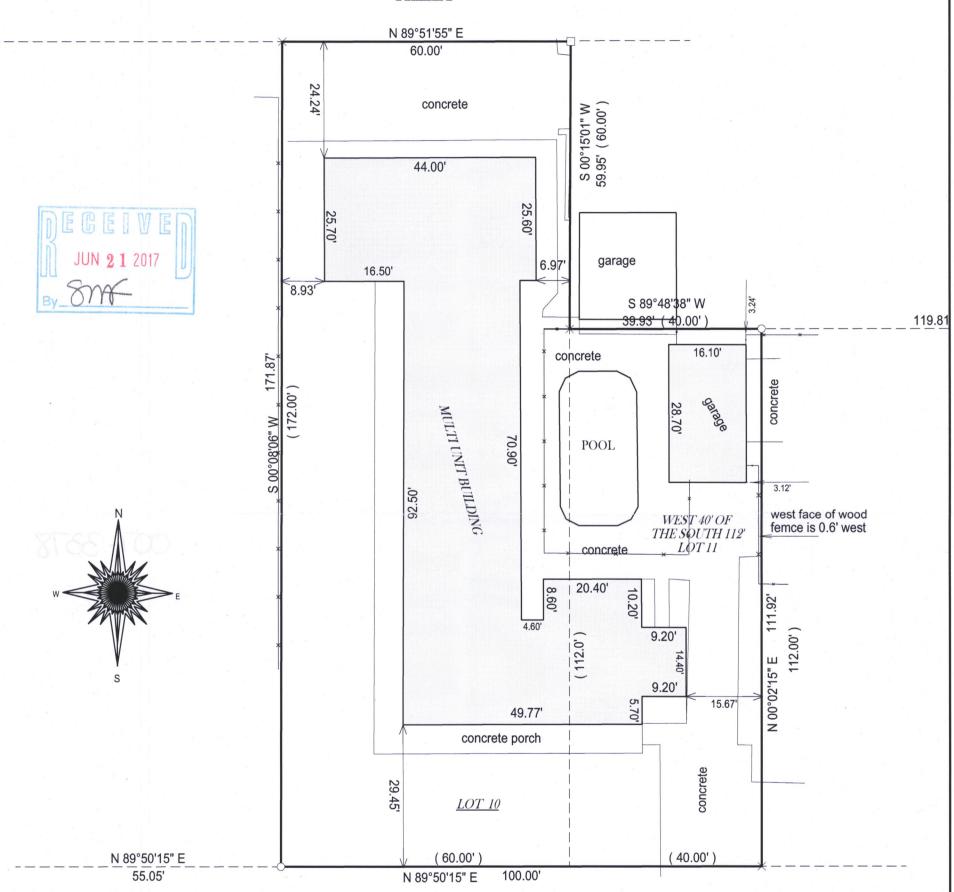

## WISCONSIN STREET

( )= recorded as

= found iron bar

= found iron pipe

= set iron pipe

= set iron bar

SCALE 1" = 20'

JOB # 17-41

A STANDARD OF THE PARTY OF THE

TAX ID # ZOP 00083

20 0 20 40 60

BASIS OF BEARING OF THIS PLAT: THE US STATE PLANE COORDINATE SYSTEM SOUTH ZONE, NAD 83 (2011) WISCORS.

I hereby certify that I have surveyed the above- described property and the above map is a is a true representation thereof and shows the size and location of the property, its exterior boundaries, the location and dimensions of all structures thereon, fences, apparant easements and roadways and visible encroachments if any.

This survey is made for the present owners of the property, and those who purchase, mortgage, or guarantee the title thereto, within one year from the date hereof.

DATED THIS 13TH DAY OF MARCH, 2017.



JEFFREY L KIMPS S - 2436 Wisconsin Professional Land Surveyor (original if signed in red)