PREPARED FOR MONICA MITCHELL D'APRILE PROPERTIES

## PLAT OF SURVEY

- OF -

LOT 46 MEADOWLAND SUBDIVISION, LOCATED IN THE SW 1/4 AND SE 1/4 OF THE SW 1/4 OF SECTION 31, TOWN 1 NORTH, RANGE 18 EAST, CITY OF LAKE GENEVA, COUNTY OF WALWORTH AND STATE OF WISCONSIN.

PATHFINDER SURVEYING INC.


(formerly)


J.K. SURVEYING INC.

P.O BOX 322

LAKE GENEVA, WI. 53147

WWW.PATHFINDERSURVEYING.NET
262-248-8303

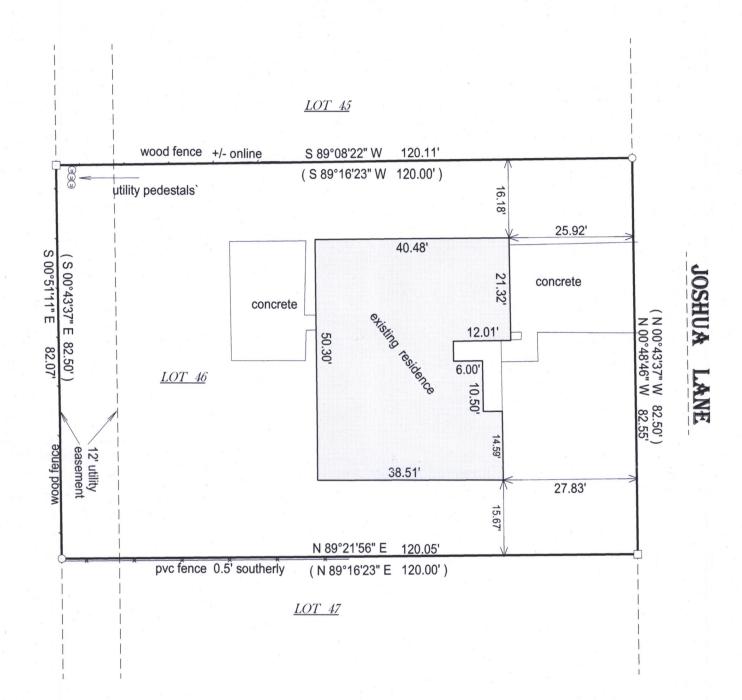

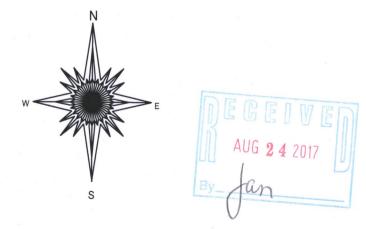

( )= recorded as

□ = found iron bar

= found iron pipe

= set iron pipe

= set iron bar

SCALE 1" = 20'

JOB # 17-193


TAX ID # ZMEA 00046

20 0 20 40 60
BASIS OF BEARING OF THIS PLAT: THE US STATE PLANE COORDINATE SYSTEM SOUTH ZONE, NAD 83. WISCORS.

I hereby certify that I have surveyed the above- described property and the above map is a is a true representation thereof and shows the size and location of the property, its exterior boundaries, the location and dimensions of all structures thereon, fences, apparant easements and roadways and visible encroachments if any.

This survey is made for the present owners of the property, and those who purchase, mortgage, or guarantee the title thereto, within one year from the date hereof.

DATED THIS 12TH DAY OF JULY, 2017.

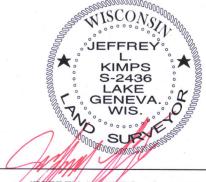

JEFFREY KIMPS S - 2436 Wisconsin Professional Land Surveyor (original if signed in red)