


# PLAT OF SURVEY

THE SOUTH 1/2 OF LOTS 18, 19 AND 20 RICH'S ADDITION TO THE CITY OF LAKE GENEVA, ACCORDING TO THE RECORD PLAT THEREOF, LOCATED IN THE SW 1/5 OF SECTION 25, TOWN 2 NORTH, RANGE 17 EAST, CITY OF LAKE GENEVA, COUNTY OF WALWORTH AND STAYE OF WISCONSIN."

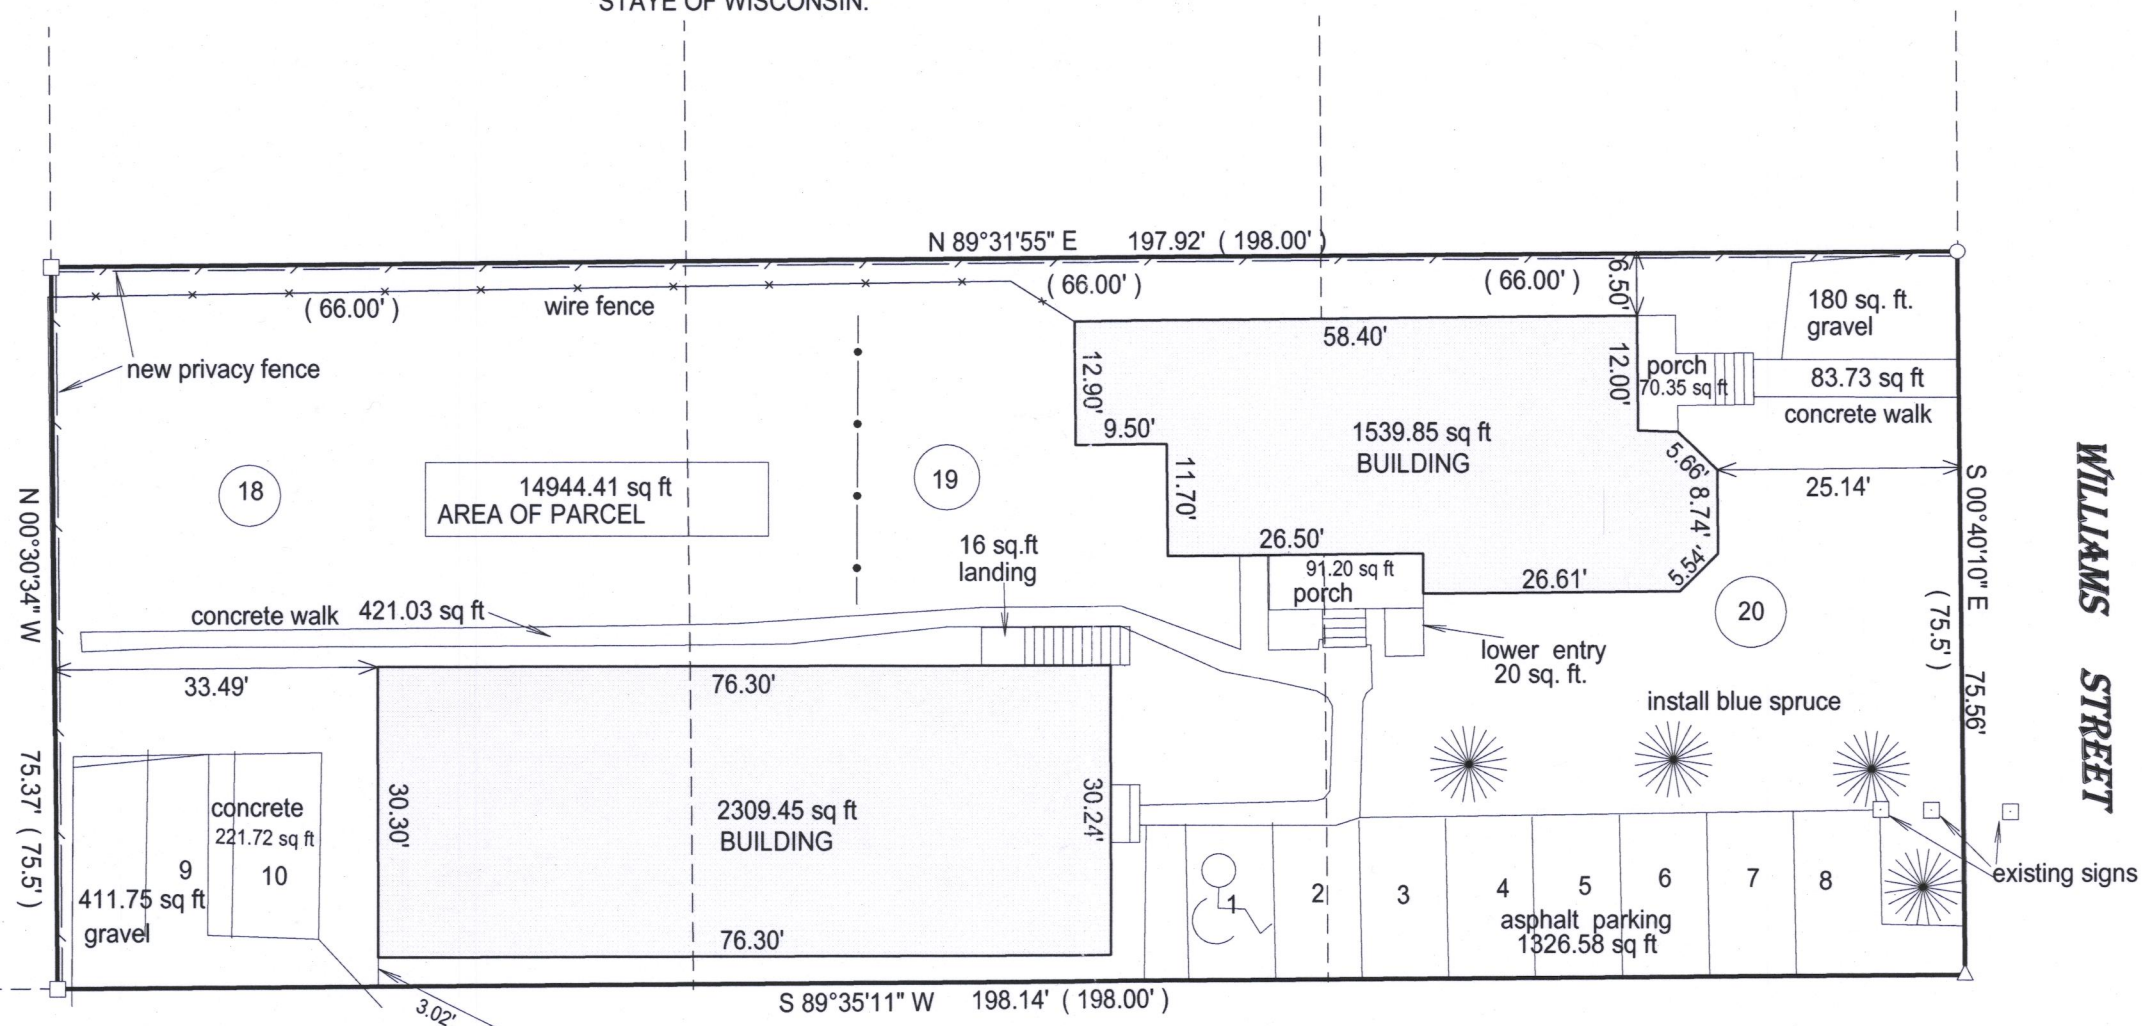

■ = set iron bar

TAX ID (# ZRA 00018

"I hereby certify that I have surveyed the above described property and that the above map is a true representation of its exterior boundary and shows the size and location of all visible structures, apparent easements and encroachments if any."

This survey is made for the present owners of the property, and those who purchase, mortgage, or guarantee the title thereto, within one year from the date hereof.

DATED THIS 6th day of June, 2107.



JEFFREY L KIMPS S - 2436  
Wisconsin Professional Land Surveyor  
( original if signed in red )

007-3416