

LOT 12 IN BLOCK 19 OF "GENEVA LAKE CRAWFORD MANUFACTURING COMPANY'S ADDITION TO GENEVA", ACCORDING TO THE RECORDED PLAT THEREOF. SAID LAND BEING IN THE CITY OF LAKE GENEVA, COUNTY OF WALWORTH AND STATE OF WISCONSIN.

SURVEY FOR: DEBBIE COBIAN OF KEEFE REAL ESTATE  
SURVEY ADDRESS: 403 WALWORTH STREET, LAKE GENEVA, WI 53147


NOTE: REFER TO A CURRENT TITLE REPORT FOR EASEMENTS, RESTRICTIONS OR COVENANTS WHICH MAY AFFECT THIS PROPERTY.

- o FOUND 1-5/16" O.D. IRON PIPE
- FOUND 3/4" DIA. IRON ROD
- + SET CHISELED CROSS-CUT
- ( ) RECORDED AS

LOT 11, BLOCK 19

LOT 12, BLOCK 19  
0.24 acres

BEARINGS HEREON RELATE TO THE SOUTH LINE  
OF BLOCK 19 OF "GENEVA LAKE CRAWFORD  
MANUFACTURING COMPANY'S ADDITION TO  
GENEVA", ASSUMED BEARING OF WEST.

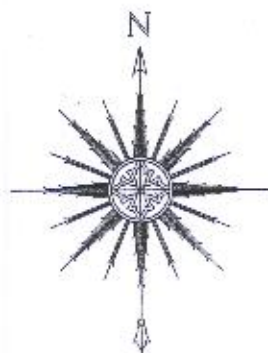

0 10' 20' 40'

SCALE: 1" = 20'

WEST

WALWORTH


(66' WIDE)

*STREET*

"I HEREBY CERTIFY THAT I HAVE SURVEYED THE ABOVE DESCRIBED PROPERTY AND THAT THE ABOVE MAP IS A CORRECT REPRESENTATION THEREOF AND SHOWS THE SIZE AND LOCATION OF THE PROPERTY, ITS EXTERIOR BOUNDARIES, THE LOCATION OF ALL VISIBLE STRUCTURES AND DIMENSIONS OF ALL PRINCIPAL BUILDINGS THEREON, BOUNDARY FENCES, APPARENT EASEMENTS, ROADWAYS AND ENCROACHMENTS, IF ANY."

"THIS SURVEY IS MADE FOR THE USE OF THE PRESENT OWNERS OF THE PROPERTY, AND THOSE WHO PURCHASE, MORTGAGE, OR GUARANTEE THE TITLE THERETO WITHIN ONE YEAR FROM DATE HEREOF."

**SATTER SURVEYING, LLC**  
LAND SURVEYS, MAPPING AND PLANNING  
272 ORIGIN STREET  
BURLINGTON, WI 53105  
262-661-4239

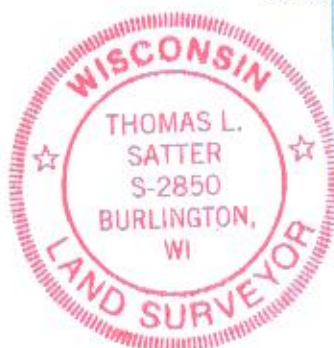

NOV 29 2017

Tar

Thomas L. Satter

THIS IS NOT AN ORIGINAL PRINT  
UNLESS THIS SEAL IS RED.

NOVEMBER 22, 2017  
DATE

111710  
JOB NUMBER

ZGC-110

007 - 3432