


PLAT OF SURVEY

LOT 20, TOWNLINE TRAILS SUBDIVISION, LOCATED IN PART OF THE NORTHEAST 1/4 OF THE NORTHWEST 1/4 AND THE SOUTHEAST 1/4 OF THE NORTHWEST 1/4 OF SECTION 6, ALL IN TOWN 1 NORTH, RANGE 18 EAST, CITY OF LAKE GENEVA, WALWORTH COUNTY, WISCONSIN

(LOT 19)

CUMBERLAND TRAIL

RECEIVED
FEB 23 2018
By Jan

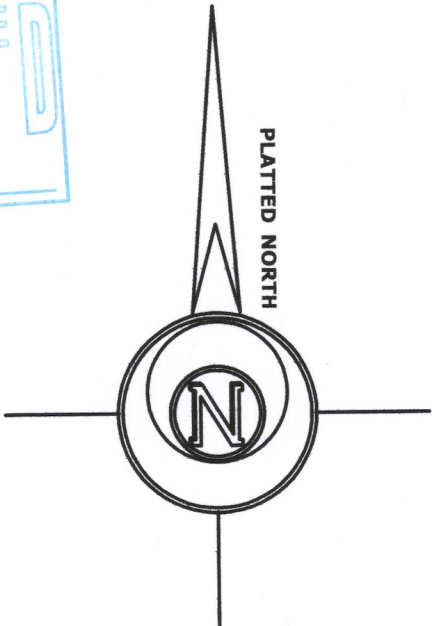

LEGEND

- + SET CUT CROSS IN SW
- ⊗ FOUND IRON PIPE 1 1/4"
- (x x) RECORDED AS DIMENSION

SCALE: 1 INCH = 20 FEET

"I hereby certify that the above described property has been surveyed by me or under my direction and that the above map is a true representation thereof and shows the size and location of the property, its exterior boundaries, the location of all visible structures and dimensions of all principal buildings thereon, boundary fences, apparent easements, roadways and visible encroachments, if any."
"This survey is made for the use of the present owners of the property, and also those who purchase, mortgage, or guarantee the title thereto within one year from date hereof."

Mark L. Miritz
MARK L. MIRITZ
WISCONSIN PROFESSIONAL
LAND SURVEYOR S-2582

REVISED RESIDENCE FEB. 10, 2017
REVISED JULY 20, TO SHOW RESIDENCE
AS BUILT

DATE: APRIL 11, 2016 JOB NO. 16.405

ZTT-20 007-3446

