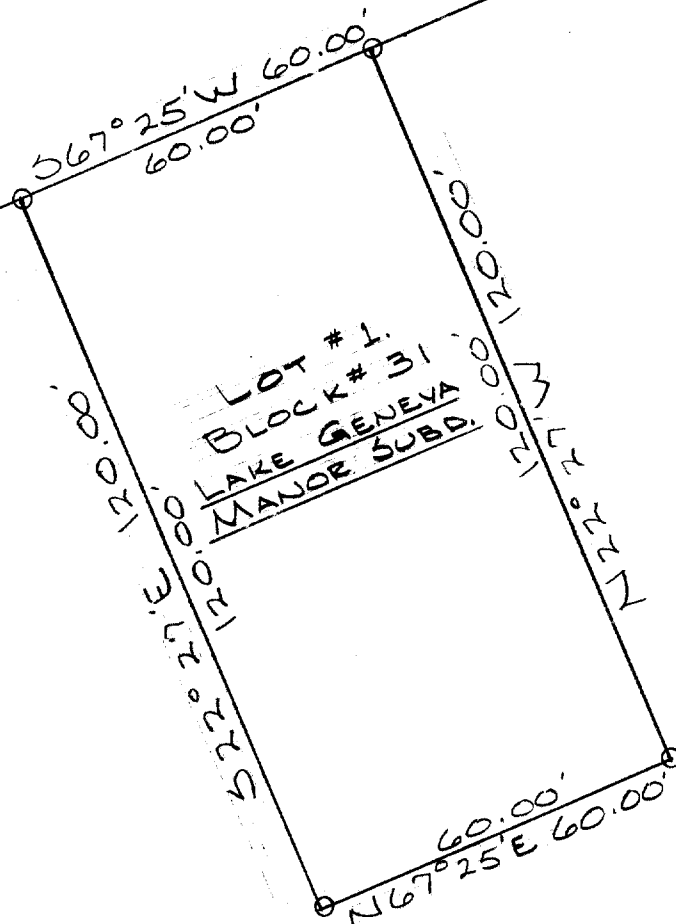
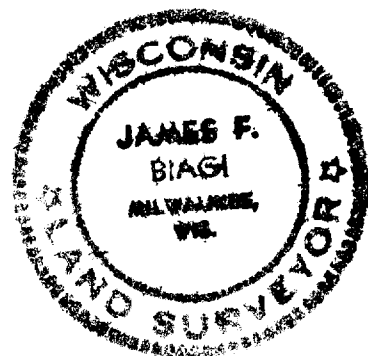


MAIN ST. (ST HWYS. 36 & 50)

O-INDICATES
IRON PIPE

DESCRIPTION :

Lot #1 Block #31 Lake Geneva Manor Subdivision of
a portion of the City of Lake Geneva, Walworth County,
Wisconsin.

CERTIFICATE:

I, James F. Biagi, surveyor, do hereby certify that I
have surveyed the property hereon described.

James F. Biagi RLS 272
Elkhorn, Wisconsin.

September 22nd 1970.