

LAND-MARK SURVEYING

Mark L. Miritz

Wisconsin Professional Land Surveyor S-2582

N9330 Knuteson Drive

Whitewater, WI 53190

Phone: (262) 495-3284


MARKMIRITZ@

LAND-MARKSURVEYING.COM

PLAT OF SURVEY

LOT 18 OF SYVER-STAD LAKE SHORE ESTATES,
LOCATED IN SECTION 1, TOWN 1 NORTH, RANGE
17 EAST, CITY OF LAKE GENEVA, WALWORTH
COUNTY, WISCONSIN.

OWNER: PINE TREE LANE LLC
824 PINE TREE LANE
LAKE GENEVA, WI 53147

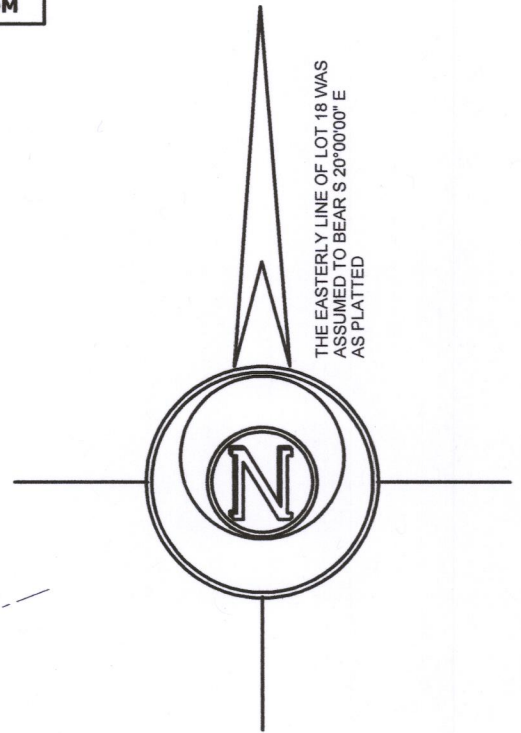


PINE TREE LANE
(50' WIDE)

LOT 17

LOT 19

LOT 18

8,153 SQ. FT.

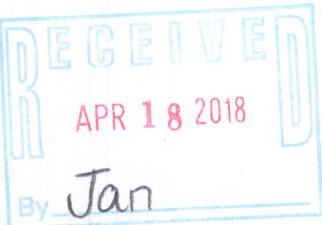

SCALE: 1 INCH = 20 FEET

NORTH KNOLL LANE

"I hereby certify that the above described property has been surveyed by me or under my direction and that the above map is a true representation thereof and shows the size and location of the property, its exterior boundaries, the location of all visible structures and dimensions of all principal buildings thereon, boundary fences, apparent easements, roadways and visible encroachments, if any."
"This survey is made for the use of the present owners of the property, and also those who purchase, mortgage, or guarantee the title thereto within one year from date hereof."

MARK L. MIRITZ
WISCONSIN PROFESSIONAL
LAND SURVEYOR S-2582

DATE: MARCH 4, 2018 JOB NO. 11.903



LEGEND

- ⊘ FOUND IRON PIPE
- ⊠ FOUND CONCRETE MONUMENT
- UTILITY PEDESTAL
- ⊕ UTILITY POLE
- (x x) RECORDED AS DIMENSION

ZSY-18

007-3456