
100 SOUTH SECOND STREET WATERFORD, WISCONSIN 53185 (262)534-5404 (FAX)534-2022

## PLAT OF SURVEY

LOTS 5 AND 6, BLOCK 14, LAKE GENEVA MANOR, A SUBDIVISION LOCATED IN SECTION 35, TOWNSHIP 2 NORTH, RANGE 17 EAST, CITY OF LAKE GENEVA, COUNTY OF WALWORTH AND STATE OF WISCONSIN.

\* REFER TO A CURRENT TITLE REPORT FOR EASEMENTS, RESTRICTIONS OR COVENANTS OF RECORD THAT MAY AFFECT THIS LAND. \*



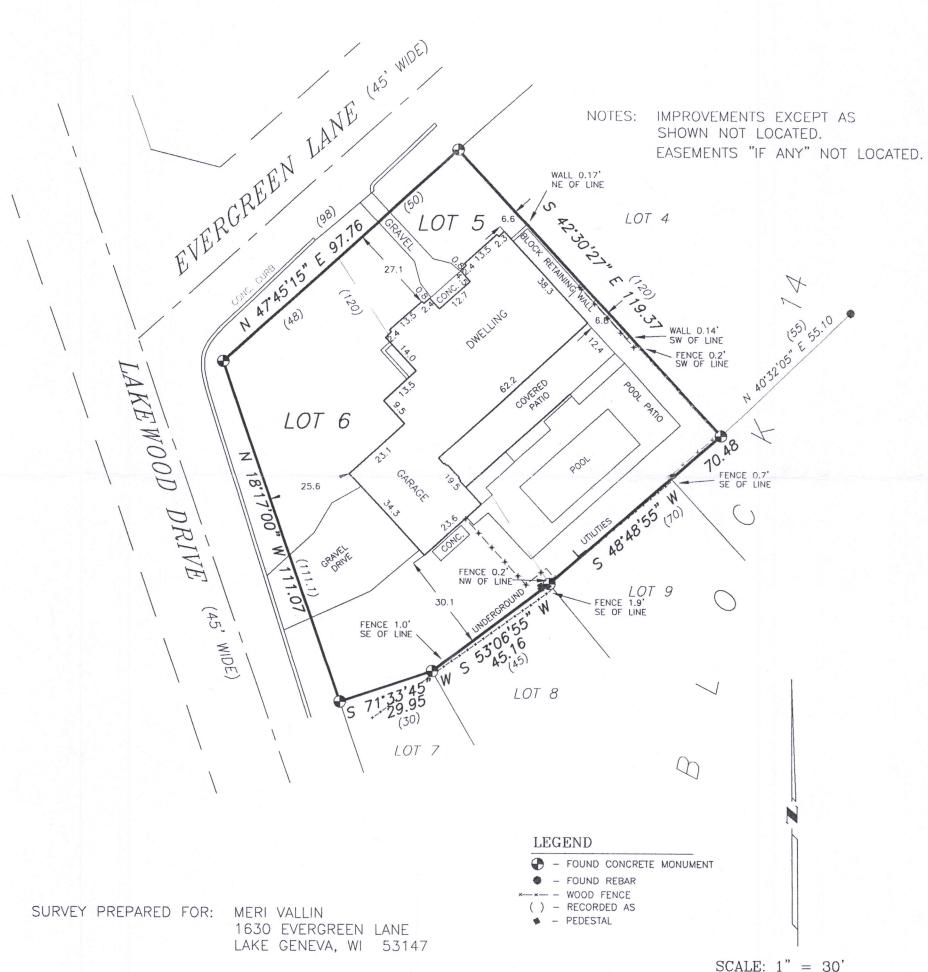



BEARINGS BASED ON THE EASTERLY LINE OF LAKE WOOD DRIVE - RECORDED AS N 18'37' W

I HEREBY CERTIFY THAT I HAVE SURVEYED THE ABOVE DESCRIBED PROPERTY AND THE ABOVE MAP IS A TRUE REPRESENTATION THEREOF AND SHOWS THE SIZE AND LOCATION OF THE PROPERTY, THE LOCATION OF ALL VISIBLE STRUCTURES AND DIMENSIONS OF ALL PRINCIPAL BUILDINGS THEREON, BOUNDARY FENCES, APPARENT EASEMENTS, ROADWAY AND VISIBLE ENCROACHMENTS, IF ANY.

THIS SURVEY IS MADE FOR THE PRESENT OWNERS OF THE PROPERTY, AND ALSO THOSE WHO PURCHASE, OR GUARANTEE THE TITLE THERETO WITHIN (1) YEAR FROM THE DATE HEREOF.

DATED AT\_\_\_\_WATERFORD, WI

THIS 15th DAY OF NOVEMBER 20 16 REVISED: MAY 17, 2017