LAND-MARK SURVEYING Mark L. Miritz

Wisconsin Professional Land Surveyor S-2582


N9330 Knuteson Drive Whitewater, WI 53190 Phone:(262)495-3284 MARKMIRITZ@ LAND-MARKSURVEYING.COM


PLAT OF SURVEY

LEGAL DESCRIPTION

LOCATED IN THE SOUTHEAST 1/4 OF THE SOUTHEAST 1/4, SECTION 36, TOWNSHIP 2 NORTH, RANGE 17 EAST, IN THE CITY OF LAKE GENEVA, WALWORTH COUNTY, WISCONSIN.

UNIT 216, SUMMERHAVEN OF LAKE GENEVA ADDENDUM NO. 2

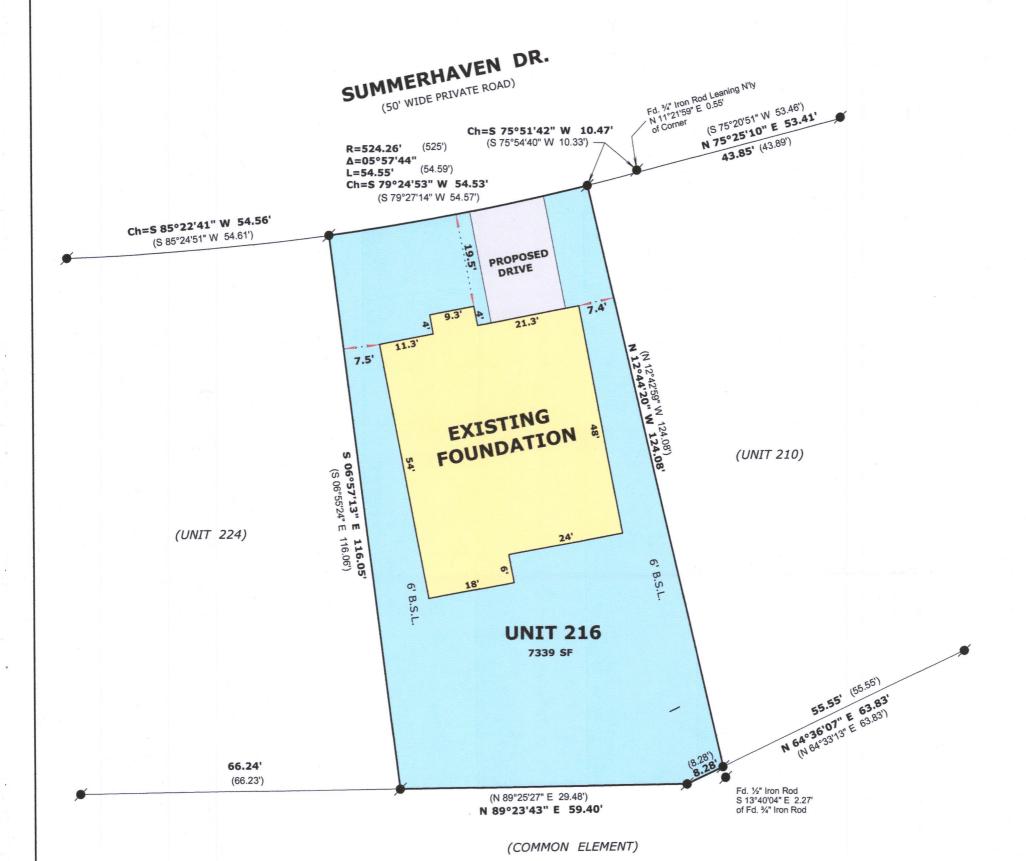

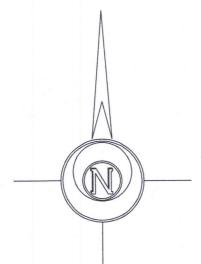





ORDERED BY: Basso Builders Inc. 405 Skyline Dr. Lake Geneva, WI 53147

SCALE: 1 INCH = 20 FEET

RECORDED AS DIMENSION

SET IRON ROD, 18" LONG, WEIGHING 1.5 LBS./LINEAL FT., 3/4" DIA.

FOUND IRON ROD

EXISTING FENCE

"I hereby certify that the above described property has been surveyed by me or under my direction and that the above map is a true representation thereof and shows the size and location of the property, its exterior boundaries, the location of all visible structures and dimensions of all principal buildings thereon, boundary fences, apparent easements, roadways and visible encroachments, if any."

"This survey is made for the use of the present owners of the property, and also those who purchase, mortgage, or guarantee the title thereto within one year from date hereof."

MARK L. MIRITZ WISCONSIN PROFESSIONAL **LAND SURVEYOR S-2582**

DATE:__ May 25, 2018

LEGEND

(xx)

REVISED JULY 26, 2018 TO SHOW FOUNDATION "AS BUILT"

ZSUM-216