



PREPARED FOR  
SUE VANDERWERFF

# PLAT OF SURVEY

- OF -

Lot 6, Block 2 of McKenna Addition, located in the City of Lake Geneva, Walworth County, Wisconsin.

PATHFINDER SURVEYING  
(a NMB Company)  
P.O BOX 322  
LAKE GENEVA, WI. 53147  
WWW.PATHFINDERSURVEYING.NET  
262-248-8303

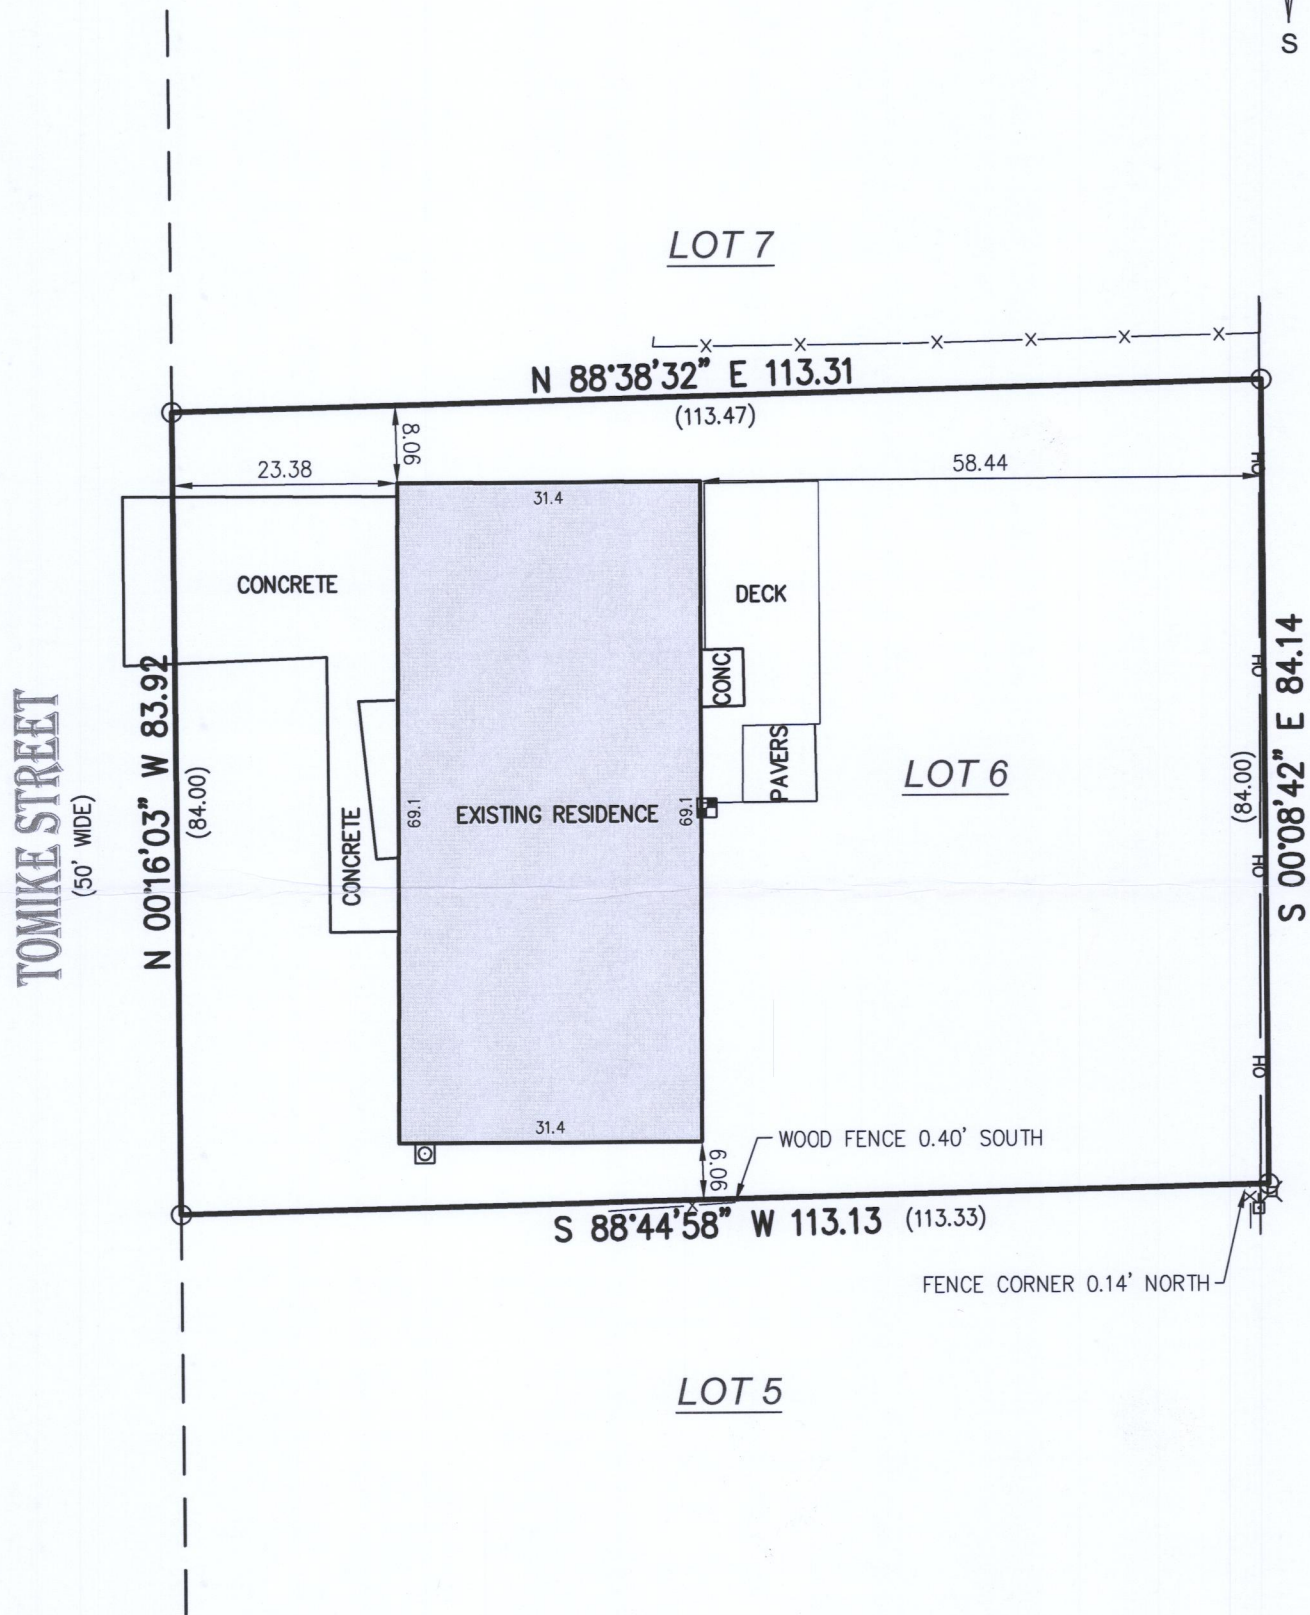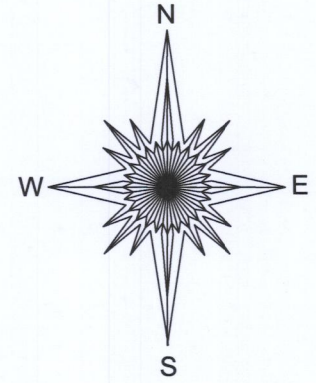

- ( ) = recorded as
- = power pole
- = found iron pipe
- OH— = overhead wires
- ⊗ = electric pedestal
- X— = fence
- = electric meter
- ⊠ = gas meter



BASIS OF BEARING OF THIS PLAT: THE US STATE PLANE COORDINATE SYSTEM SOUTH ZONE, NAD 83. WISCORS.

I hereby certify that I have surveyed the above- described property and the above map is a true representation thereof and shows the size and location of the property, its exterior boundaries, the location and dimensions of all structures thereon, fences, apparent easements and roadways and visible encroachments if any to the best of my knowledge and belief.



This survey is made for the present owners of the property, and those who purchase, mortgage, or guarantee the title thereto, within one year from the date hereof.

SCALE 1" = 20'

JOB # 2018.0249.01

TAX ID # ZMC 00023

DATED THIS 13TH DAY OF AUGUST, 2018.

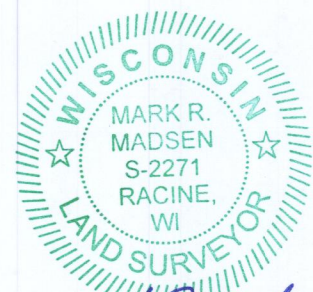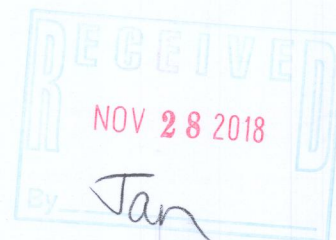

*Mark R. Madsen*

MARK R. MADSEN S - 2271  
Wisconsin Professional Land Surveyor

ZMC-23 007-3509