
PLAT OF SURVEY -OF-

THE SOUTH 1/2 OF LOTS 120, 121 AND 122 OF COLUMBIAN SUBDIVISION OF THE CITY OF LAKE GENEVA, WALWORTH COUNTY, WISCONSIN.

SURVEY FOR: FRED GELDERMANN OF @ PROPERTIES SURVEY ADDRESS: 556 MAXWELL STREET, LAKE GENEVA, WI 53147

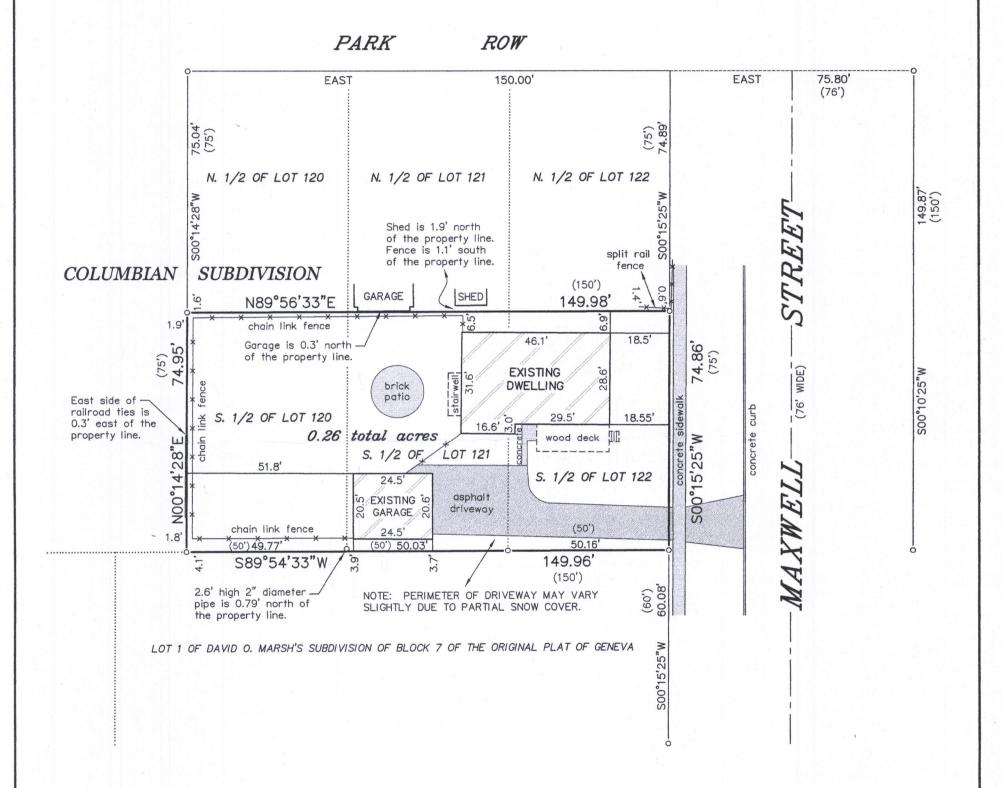

LEGEND

o FOUND IRON PIPE

() RECORDED AS

DEC 1 9 2018

O THE ABOVE

"I HEREBY CERTIFY THAT I HAVE SURVEYED THE ABOVE DESCRIBED PROPERTY AND THAT THE ABOVE MAP IS A CORRECT REPRESENTATION THEREOF AND SHOWS THE SIZE AND LOCATION OF THE PROPERTY, ITS EXTERIOR BOUNDARIES, THE LOCATION OF ALL VISIBLE STRUCTURES AND DIMENSIONS OF ALL PRINCIPAL BUILDINGS THEREON, BOUNDARY FENCES, APPARENT EASEMENTS, ROADWAYS AND ENCROACHMENTS, IF ANY."


"THIS SURVEY IS MADE FOR THE USE OF THE PRESENT OWNERS OF THE PROPERTY, AND THOSE WHO PURCHASE, MORTGAGE, OR GUARANTEE THE TITLE THERETO WITHIN ONE YEAR FROM DATE HEREOF."

SATTER SURVEYING, LLC

LAND SURVEYS, MAPPING AND PLANNING

272 ORIGEN STREET BURLINGTON, WI 53105 262-661-4239 BEARINGS HEREON RELATE TO THE NORTH LNE OF LOTS 120-122 OF COLUMBIAN SUBDIVISION. ASSUMED BEARING OF EAST.



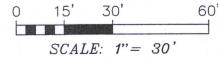



THIS IS NOT AN ORIGINAL PRINT UNLESS THIS SEAL IS RED.

Thomas L. Satter

THOMAS L. SATTER S-2850

DECEMBER 1, 2018

DATE

JOB NUMBER