


PLAT OF SURVEY OF

The East 107 feet of Lot 1, Block 4, and the East 107 feet of the North 50 feet of Lot 4, Block 4 Of Goodsell's Subdivision of Blocks 3 and 4 of the Original Plat of the City of Lake Geneva, Walworth County, Wisconsin.

CERTIFICATE

I, James F. Biagi, surveyor, do hereby certify that I have surveyed the lands hereon described, and that the improvements are as hereon shown.

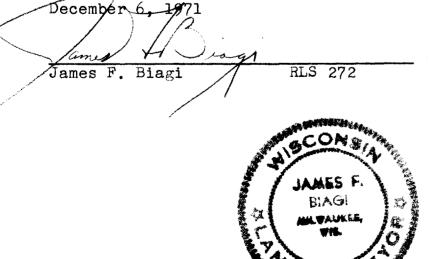

Part of Lots 1 and 4 of Block 4 of Goodsell's Subdivision of Blocks 3 and 4, Lake Geneva					
				SCALE	drawn by ALB
				1"=301	REVISED
DATE	APPROVED B	Y			DRAWING NUMBER
12/6/71	JFB				218-71