

LAND-MARK SURVEYING

Mark L. Miritz

Wisconsin Professional Land Surveyor S-2582


N9330 Knuteson Drive
Whitewater, WI 53190

Phone: (262) 495-3284


MARKMIRITZ@
LAND-MARKSURVEYING.COM

PLAT OF SURVEY

LOT 43 AND LOT 44 OF PARADISE VISTA
SUBDIVISION, LOCATED IN THE SOUTHEAST
1/4 OF SECTION 1, TOWN 1 NORTH, RANGE
17 EAST, CITY OF LAKE GENEVA, WALWORTH
COUNTY, WISCONSIN.

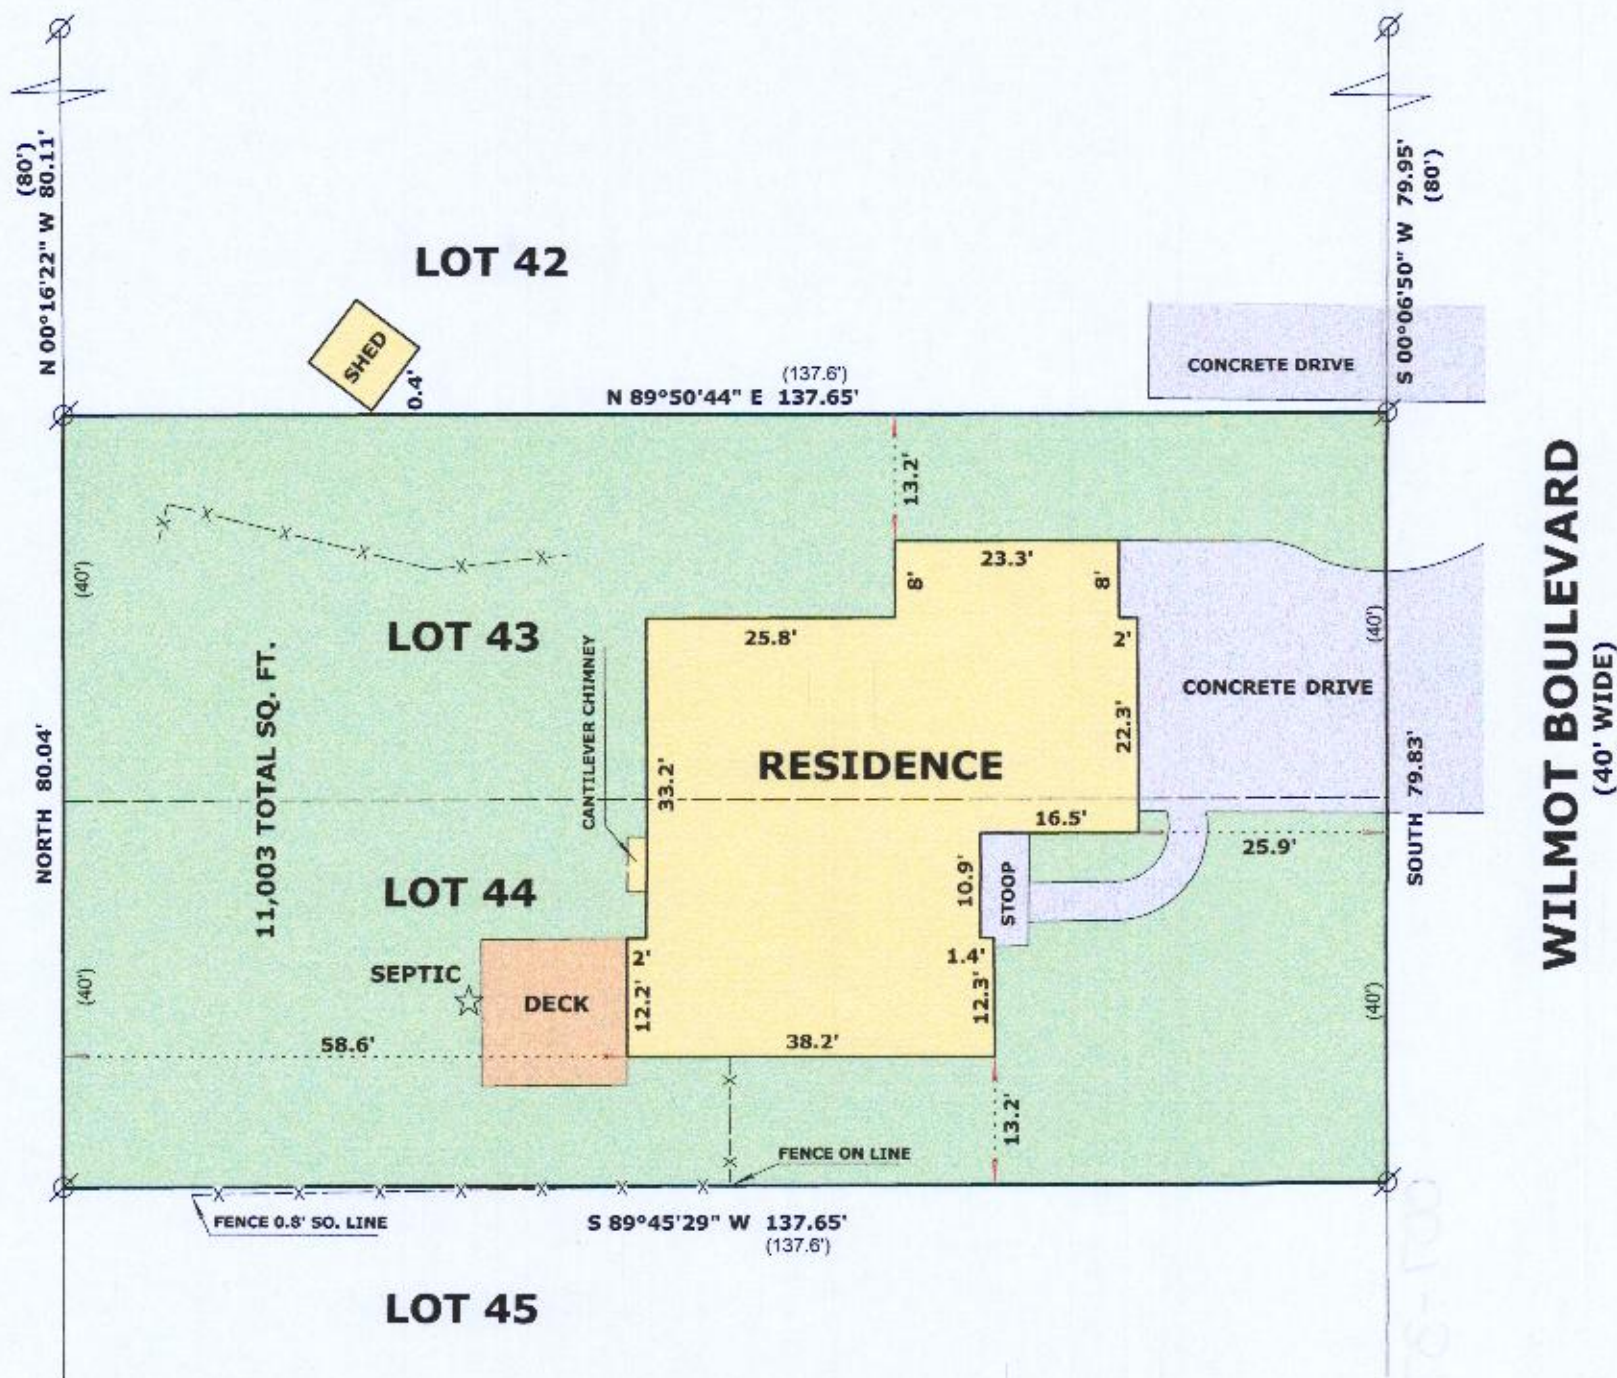

ORDERED BY:
FAIRWYN
875 E. TOWNLINE ROAD
LAKE GENEVA, WI 53147

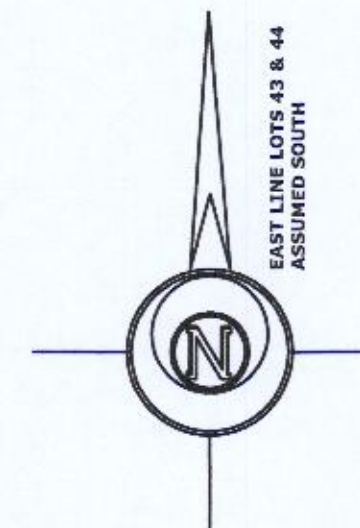

LEGEND

- Ø FOUND IRON PIPE
- (x x) RECORDED AS DIMENSION
- x - x - EXISTING WOOD FENCE

SCALE: 1 INCH = 20 FEET

"I hereby certify that the above described property has been surveyed by me or under my direction and that the above map is a true representation thereof and shows the size and location of the property, its exterior boundaries, the location of all visible structures and dimensions of all principal buildings thereon, boundary fences, apparent easements, roadways and visible encroachments, if any."

"This survey is made for the use of the present owners of the property, and also those who purchase, mortgage, or guarantee the title thereto within one year from date hereof."

Mark L. Miritz
MARK L. MIRITZ
WISCONSIN PROFESSIONAL
LAND SURVEYOR S-2582

DATE: FEB. 26, 2020 JOB NO. 20.205



ZPAV-5

007-3731