
## PLAT OF SURVEY

LOCATION:

Dodge Street, Lake Geneva, Wisconsin

## LEGAL DESCRIPTION:

Lot 6 of CERTIFIED SURVEY MAP NO. 4789, being a re-division of Lot 4 of C.S.M. No. 4770, being part of the Northwest 1/4 of the Northeast 1/4 of Section 35, Town 2 North, Range 17 East, in the City of Lake Geneva, Walworth County, Wisconsin.

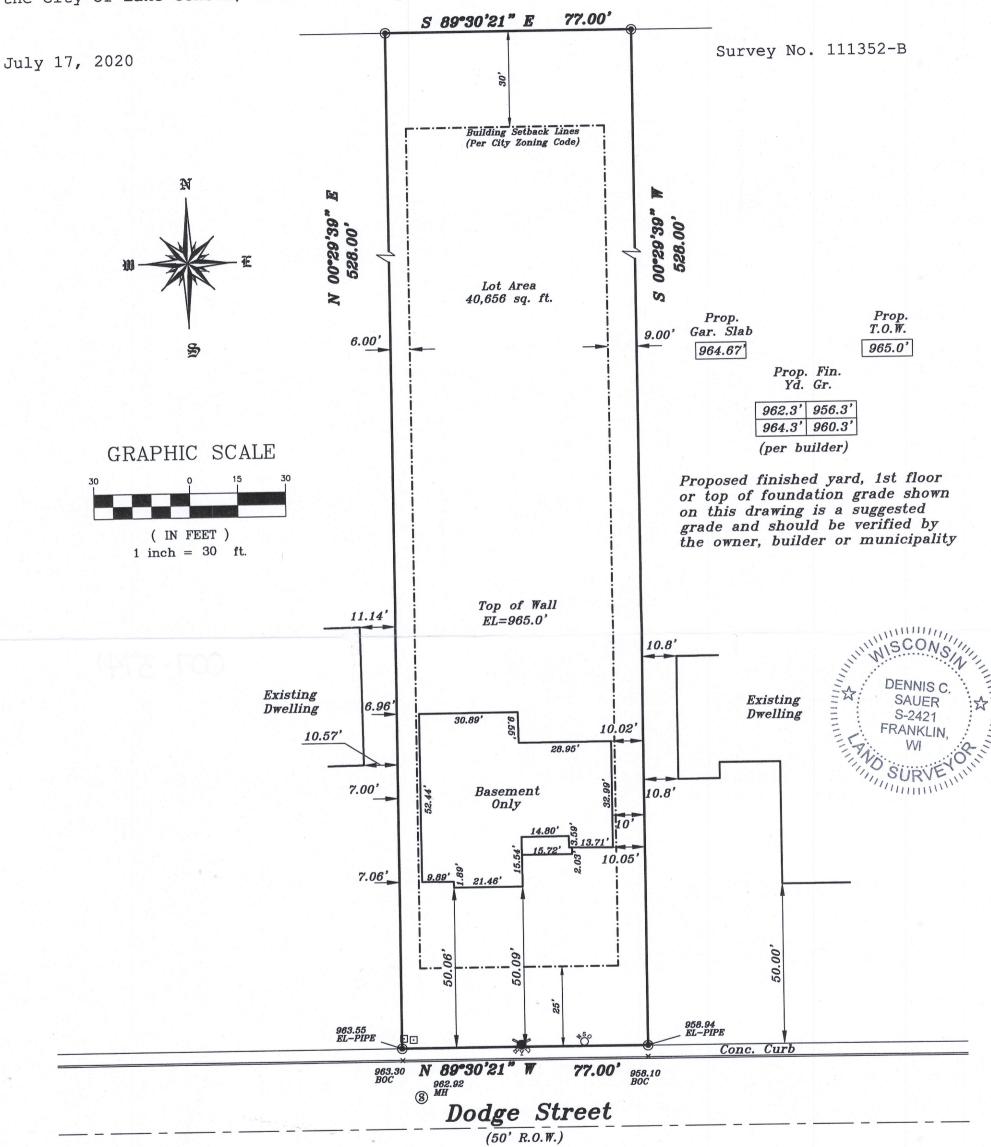

## METROPOLITAN SURVEY SERVICE, INC.

PROFESSIONAL LAND SURVEYORS AND CIVIL ENGINEERS 9415 West Forest Home Avenue, Suite 202 Hales Corners, Wisconsin 53130 PH. (414) 529-5380 FAX (414) 529-9787

email address: survey@metropolitansurvey.com

○ — Denotes Iron Pipe Set



I HEREBY CERTIFY THAT I HAVE SURVEYED THE ABOVE DESCRIBED PROPERTY AND THAT THE ABOVE MAP IS A TRUE REPRESENTATION THEREOF AND SHOWS THE SIZE AND LOCATION OF THE PROPERTY. ITS EXTERIOR BOUNDARIES, THE LOCATION OF ALL VISIBLE STRUCTURES AND DIMENSIONS OF ALL PRINCIPAL BUILDINGS THEREON, BOUNDARY FENCES, APPARENT EASEMENTS AND ROADWAYS AND VISIBLE ENCROACHMENT, IF ANY.

THIS SURVEY IS MADE FOR THE EXCLUSIVE USE OF THE PRESENT OWNERS OF THE PROPERTY, AND ALSO THOSE WHO PURCHASE, MORTGAGE, OR GUARANTEE THE TITLE THERETO WITHIN ONE (1) YEAR FROM THE DATE HEREOF.

SIGNED

**Dennis C. Sauer Professional Land Surveyor S-2421** 

007-3741