
Vanderstappen Land Surveying, Inc. www.vandersinc.com 1316 N. Madison St. Woodstock, Illinois 60098 815-337-8310 fax 815-337-8314 Always faithful to the property line"

PLAT OF SURVEY

Lot 60 in Symphony Bay, being a redivision of all of vacated Southland Farms Subdivision, except Lots 74, 85, 231 and 232 and portions of Townline Road and Bloomfield Road previously dedicated to the public, being located in the Northwest Quarter of the Northeast Quarter, the Northeast Quarter of the Northeast Quarter, the Southeast Quarter of the Northeast Quarter and the Southwest Quarter of the Northeast Quarter of Section 6 and the Southwest Quarter of the Northwest Quarter and the Northwest Quarter of the Northwest Quarter of Section 5 all in Township 1 North, Range 18 East, according to the Plat thereof recorded May 31, 2016 as Document No. 926074, in the City of Lake Geneva, Walworth County, Wisconsin.

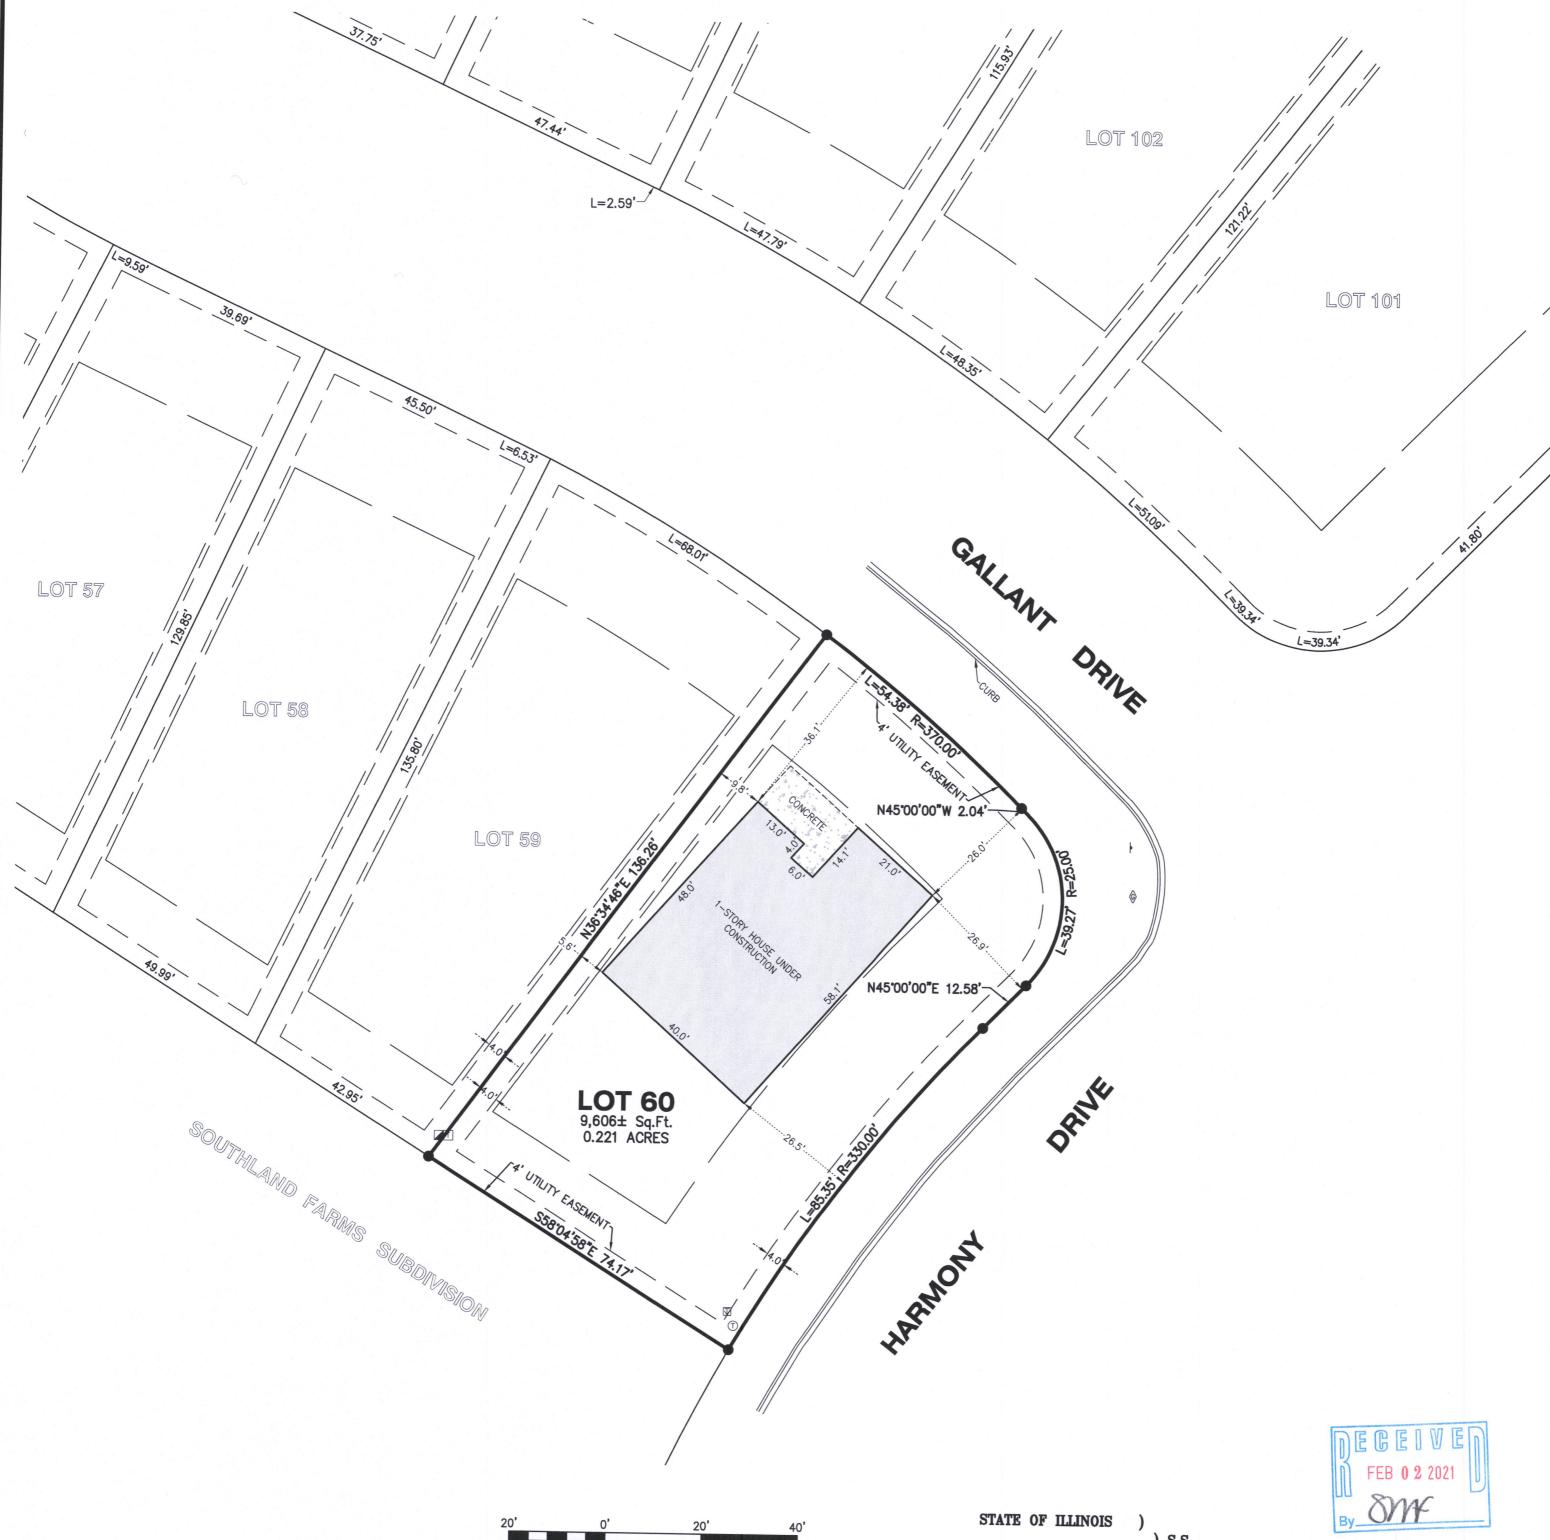

CLIENT: FAIRWYN DEVELOPMENT

DRAWN BY: BSE CHECKED BY: WJV SCALE: <u>1"=20'</u> SEC. 05 T. 01 R. 18 E. BASIS OF BEARING: ASSUMED

P.I.N.: ZSB 00060

JOB NO.: <u>170870.060-B</u> FIELDWORK COMP.: 12/28/20 BK. ALL DISTANCES SHOWN IN FEET AND DECIMAL PARTS THEREOF CORRECTED TO 68° F.

Compare your description and site markings with this plat and AT ONCE report any discrepancies which you may find.

SCALE: 1" = 20'

NOTE: Only those Building Line Restrictions or

* No distance should be assumed by scaling.

* No representation as to ownership, use,

or possession should be hereon implied.

building lines or easements.

unless shown and noted.

Easements shown on a Recorded Subdivision Plat are

surveyed contains a proper description of the required

shown hereon unless the description ordered to be

* No underground improvements have been located

* This Survey and Plat of Survey are void without

original embossed or colored seal and signature

) S.S.

COUNTY OF McHENRY)

In my professional opinion, and based on my observations, I hereby certify that the above described property has been surveyed under my direction and that the above map is a true representation thereof and shows the size and location of all visible structures, and dimensions of all principle buildings thereon, boundary fences, apparent easements, roadways, and visible encroachments, if any. This survey is made for the use of the present owners of the property, and also those who purchase, mortgage, or guarantee the title thereto within one year from the date hereof.

Dated at Woodstock, McHenry County, Illinois 12/29 A.D., 20 20.

Vanderstappen Land Surveying, Inc. Design Firm No. 184-002792

Wisconsin Registered Land Surveyor No. S1777

0800-0999\170870_V-170870\LSS\170870.080-B LSS.dwg-Layout1-1/25/2021 11:41 AM