
HAROLD H. KOLB

REGISTERED PROFESSIONAL LAND SURVEYOR LAKE GENEVA, WISCONSIN




N

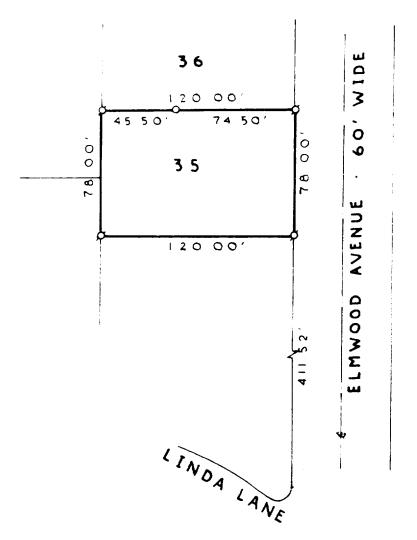

SCALE: 1" = 60'

LEGEND

- ϕ IRON PIPE FOUND
- O IRON PIPE PLACED
- -- CONCRETE MONUMENT
- X SPIKE

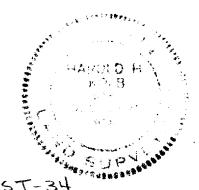

FIAT OF STRUCK

Ter 31, Starway Attack of the

The property of the straight of the state of

Consisting Williams

I. HAROLD H. KOLB, DO HEREBY CERTIFY THAT I HAVE SURVEYED THE PROPERTY HEREON DESCRIBED ACCORDING TO THE OFFICIAL RECORDS, AND THAT THE PLAT HEREON IS A CORRECT REPRESENTATION OF THE LOT LINES.

Harold W. Kolt

HAROLD H. KOLB

WISCONSIN REGISTERED LAND SURVEYOR, S-187

. DATE October 8,1971

7-387