## Plat of Survey



1 North, Range 17 East, City of Lake Geneva, Walworth County, Wisconsin.


a subdivision located in the Northwest 1/4 of the Northeast 1/4 of Section 1, Town

Richard & Jen Glauser

601 Sue Ann Drive

Lake Geneva, Wisconsin. 53147



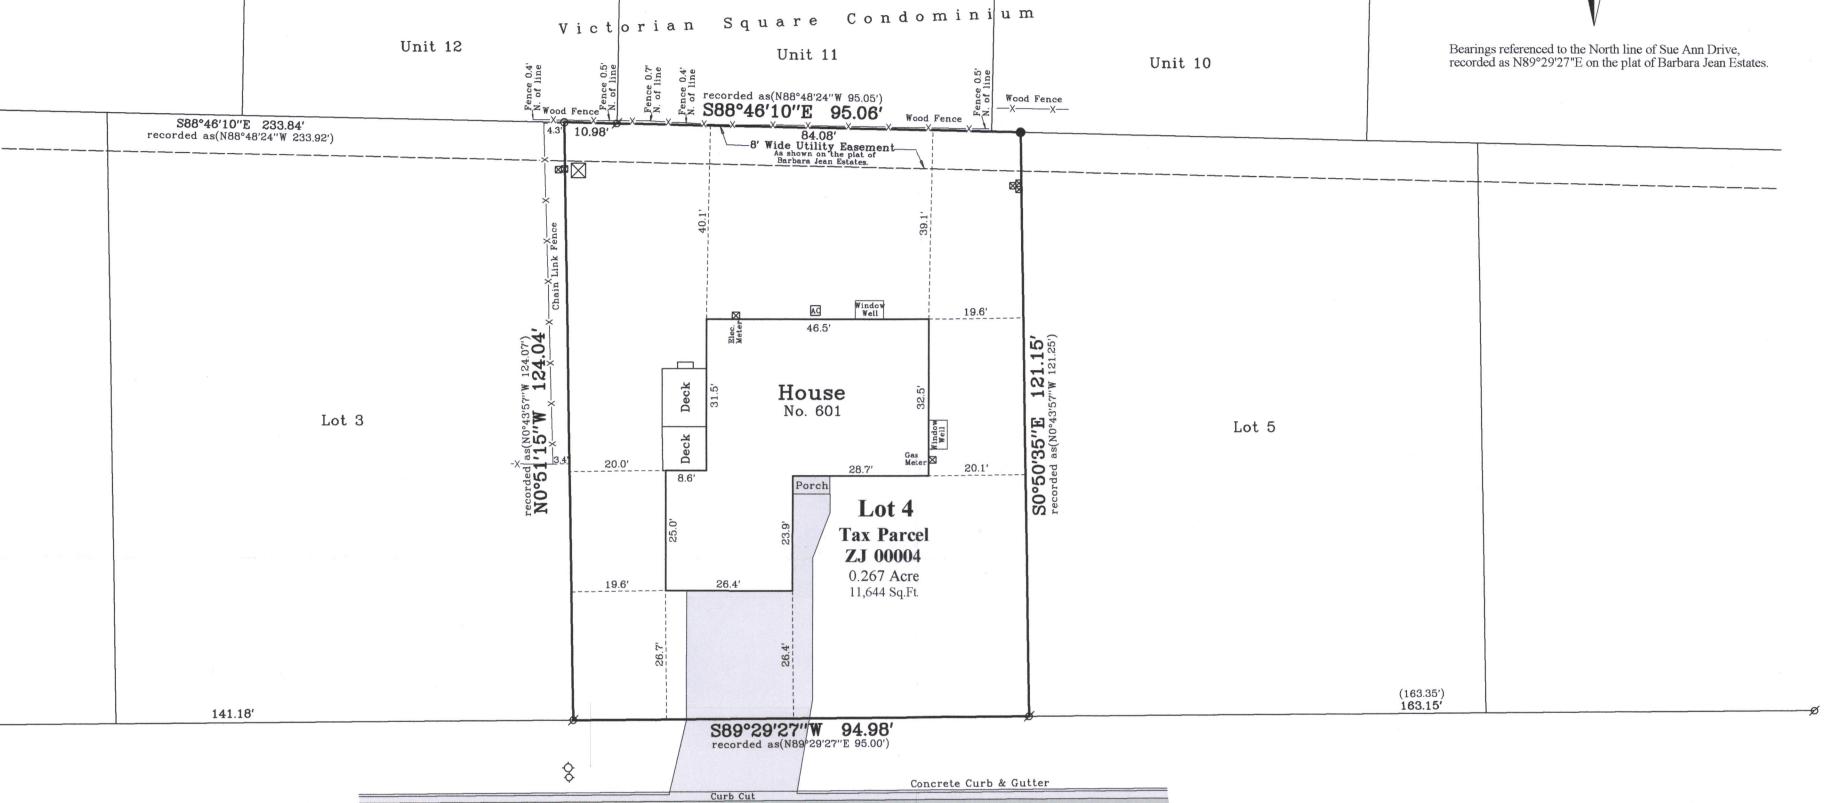

## Sue Ann Drive

Concrete Curb & Gutter

Overhead Wires

SCONSIA **DOUGLAS** OLSON S-2093 ELKHORN, Not Certified Unless Stamped in Red.



## Notes:

1) This Plat of Survey is not certified unless signed and sealed in red ink.

2) This survey is subject to Wisconsin lien laws. This Plat of Survey is the notice of intent to file lien. Lien waiver required.

3) The Survey Date shown on this Plat of Survey is the completion date of the field work.

Copyright ©2021 by Olson Land Surveying, LLC.

All rights reserved. No part of this survey plat may be reproduced or transmitted in any form by any means - graphic, electronic, or mechanical, including photocopying, tracing, or information storage and retrieval systems - without permission in writing from Douglas G. Olson, Olson Land Surveying, LLC.

I hereby certify that I have surveyed the above described property in compliance with Chapter A-E 7 of the Wisconsin Administrative Code and that the map hereon is correct to the best of my professional knowledge and belief and shows the size and location of the property, its exterior boundaries, the location and dimensions of all visible structures thereon, boundary fences, apparent easements and roadways and visible encroachments, if any.

This survey is made for the exclusive use of the present owners of the property, and also those who purchase, mortgage or guarantee title thereto, within one year from

Wisconsin Professional Land Surveyor - 2093

Douglas G. Olson

North South East West Degrees Minutes Seconds Sconds Distance Feet Inches ZOMÞĒ...Ē.

Reference Nun 2021.025

of

2021.025