
MILANKO DJURDJULOV

Lot number Twelve (12) in Block Three (3) of Wheeler's Addition to the Village of Geneva (now City of Lake Geneva) Walworth County, Wisconsin, According to a plat thereof of record in the Office of the Register of Deeds Office in and for said Walworth County.

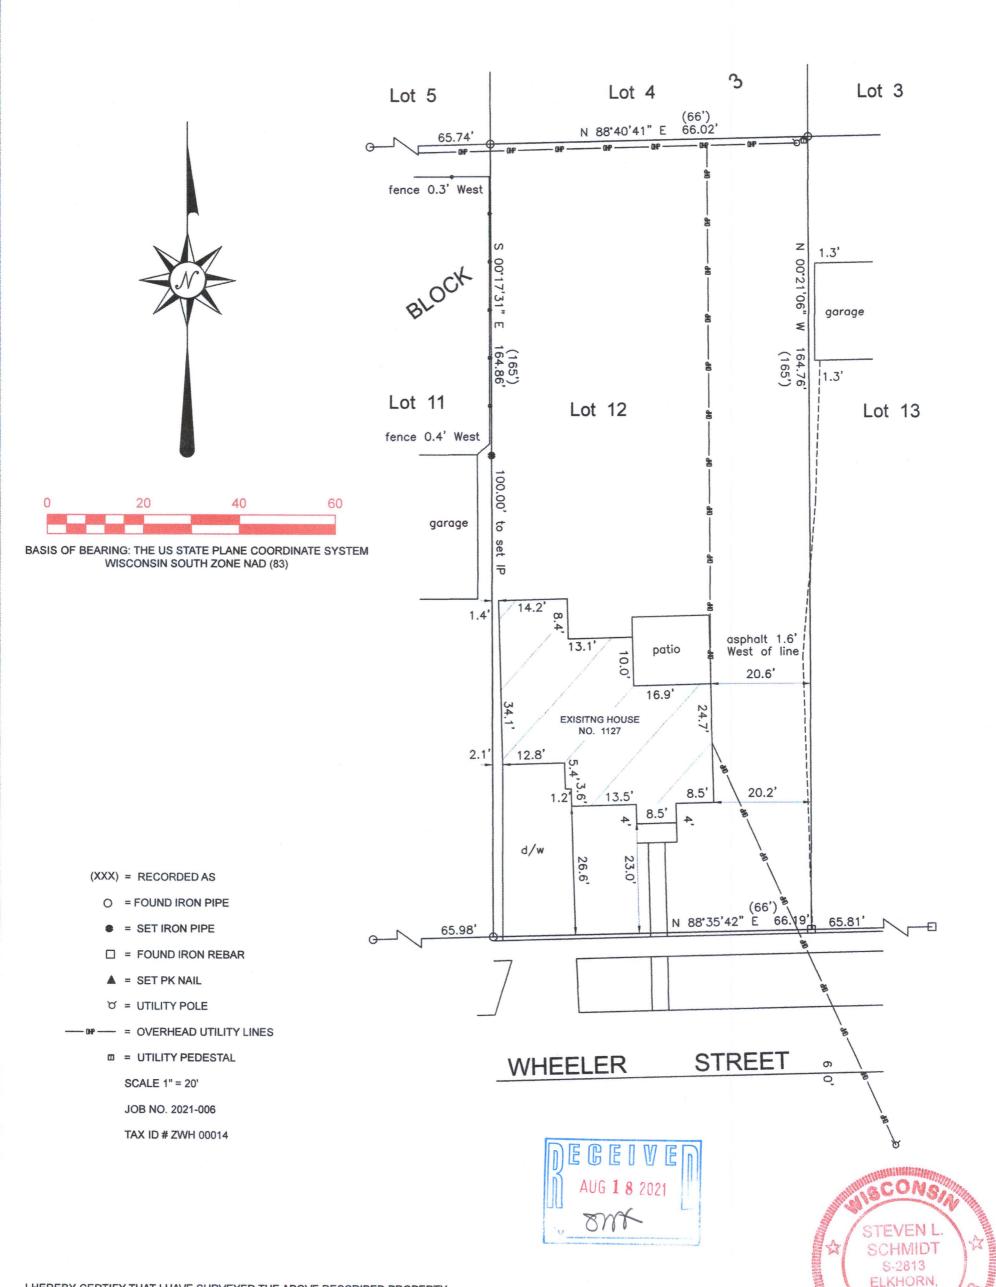

I HEREBY CERTIFY THAT I HAVE SURVEYED THE ABOVE DESCRIBED PROPERTY AND THE ABOVE MAP IS A TRUE REPRESENTATION THEREOF AND SHOWS THE SIZE AND LOCATION OF THE PROPERTY, ITS EXTERIOR BOUNDARIES, THE LOCATION AND DIMENSIONS OF ALL STRUCTURES THEREON, FENCES, APPARENT EASEMENTS, ROADWAYS, AND VISIBLE ENCROACHMENTS, IF ANY.

THIS SURVEY IS MADE FOR THE PRESENT OWNERS OF THE PROPERTY, AND THOSE WHO PURCHASE, MORTGAGE, OR GUARANTEE THE TITLE THERETO WITHIN ONE YEAR FROM THIS DATE HEREOF.

DATED THIS 30TH DAY OF MARCH 2021

ZWH-14

STEVEN L SCHMIDT S - 2813 Wisconsin Professional Land Surveyor

WI

SURY