


# PLAT OF SURVEY AND TOPOGRAPHIC MAPPING

LOCATED IN PART OF THE SW 1/4 OF THE NE 1/4 OF SECTION 1, TOWN 1 NORTH, RANGE 17 EAST,  
CITY OF LAKE GENEVA, WALWORTH COUNTY, WISCONSIN

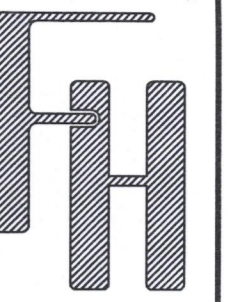


PLAT OF SURVEY

WORK ORDERED BY --  
KENTON MARTZKE  
1144 ROLLING LANE  
LAKE GENEVA, WISCONSIN 53147

FARRIS, HANSEN & ASSOCIATES, INC.  
ENGINEERING - ARCHITECTURE - SURVEYING  
7 RIDGWAY COURT P.O. BOX 437  
ELKHORN, WISCONSIN 53121  
OFFICE: (262) 723-2098 FAX: (262) 723-5886

GRID NORTH  
WISCONSIN STATE PLANE COORDINATE SYSTEM  
SOUTH ZONE (MAD-43)  
NAD 83  
SECTION 1 - 17 BEARS  
S 88°48'13" E

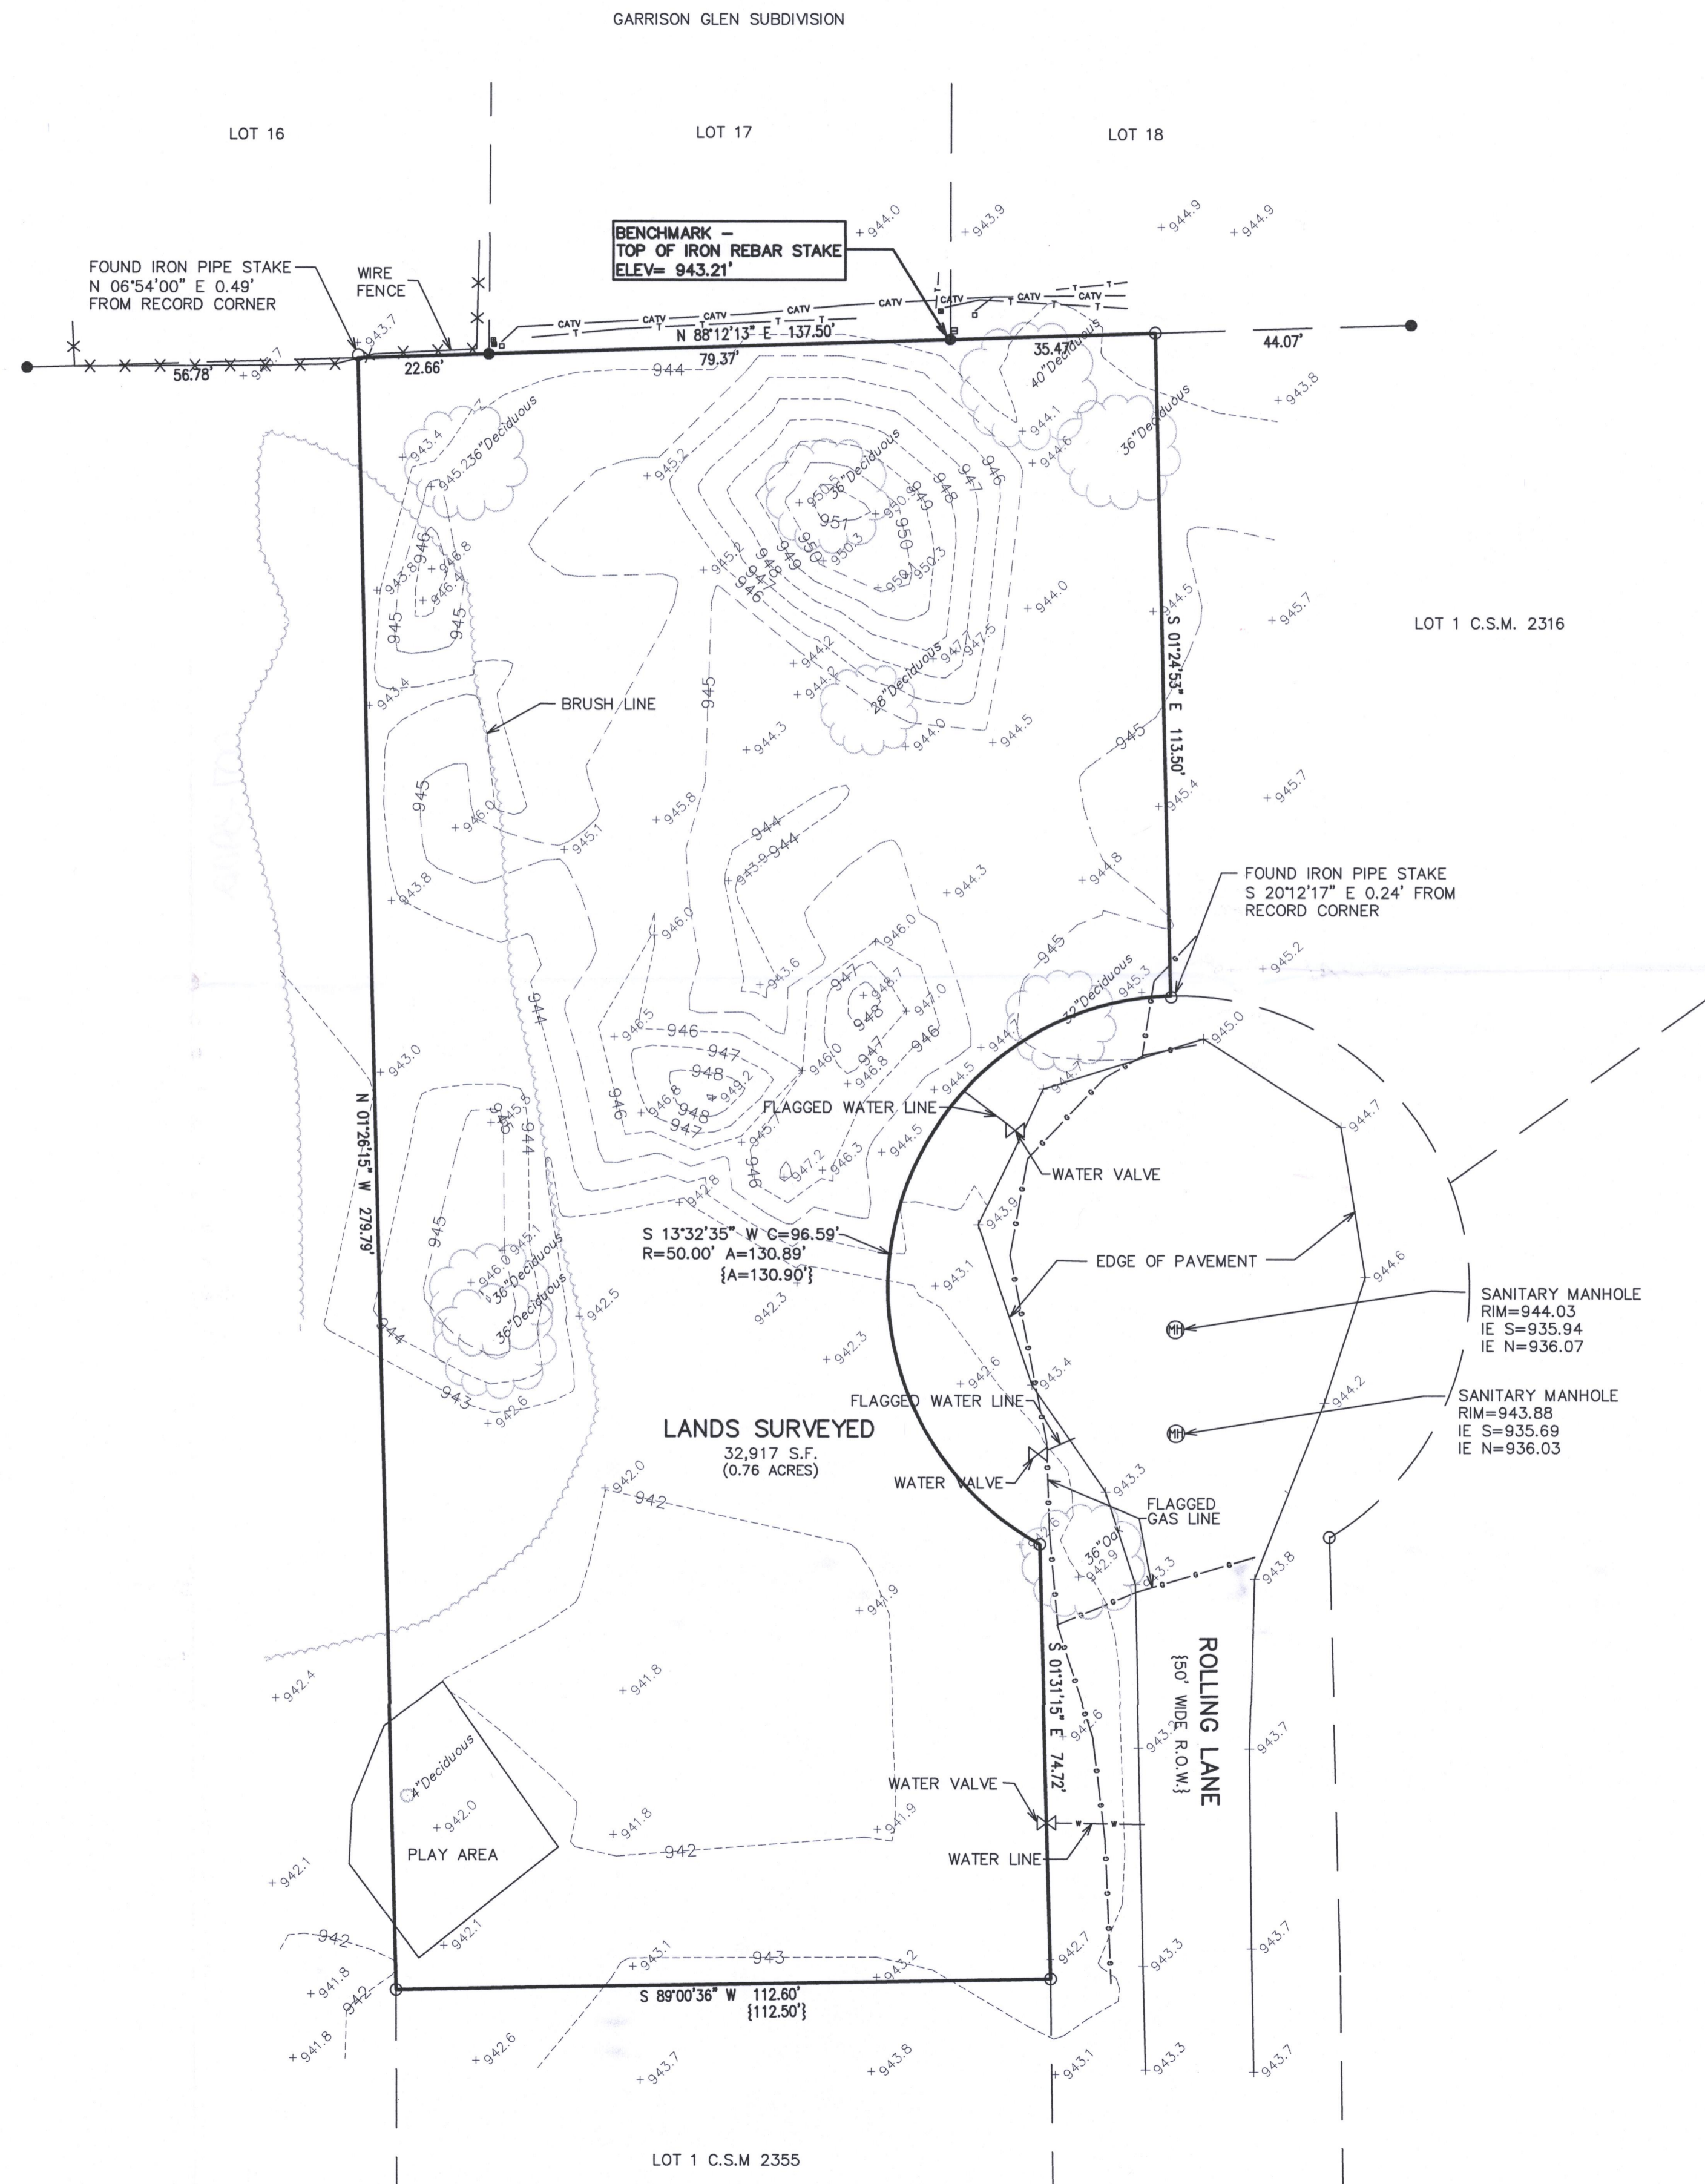

- LEGEND**
- = FOUND IRON PIPE STAKE
  - = FOUND IRON REBAR STAKE
  - = ELECTRIC TRANSFORMER
  - = CABLE TV BOX
  - = TELEPHONE BOX
  - = ELECTRIC BOX
  - CATV--- = FLAGGED CABLE LINE LOCATED
  - T-T- = FLAGGED TELEPHONE LINE LOCATED
  - {XXX} = RECORDED AS

RECEIVED  
JAN 13 2022  
By: CHA

NOTE: COPIES OF THIS MAP TO WHICH THE FOLLOWING CERTIFICATE WILL APPLY SHOW THE SURVEYOR'S ORIGINAL SEAL AND SIGNATURE IN RED INK. COPIES BY ANY OTHER MEANS MAY HAVE ALTERATIONS WHICH DO NOT REPRESENT THE SURVEYOR'S WORK PRODUCT.

I HEREBY CERTIFY THAT THE ABOVE DESCRIBED PROPERTY HAS BEEN SURVEYED UNDER MY DIRECTION AND THAT THE ABOVE MAP IS A TRUE REPRESENTATION THEREOF AND SHOWS THE SIZE AND LOCATION OF THE PROPERTY AND ITS EXTERIOR BOUNDARIES. THIS SURVEY IS MADE FOR THE USE OF THE PRESENT OWNERS OF THE PROPERTY, AND ALSO THOSE WHO PURCHASE, MORTGAGE, OR GUARANTEE THE TITLE THERETO WITHIN ONE YEAR FROM THE DATE HEREOF.




DATED: 12/30/2021

*Christopher A. Hodges*  
CHRISTOPHER A. HODGES P.L.S. 2760

REVISIONS

PROJECT NO.  
10604  
DATE  
12/30/2021  
SHEET NO.  
1 OF 1

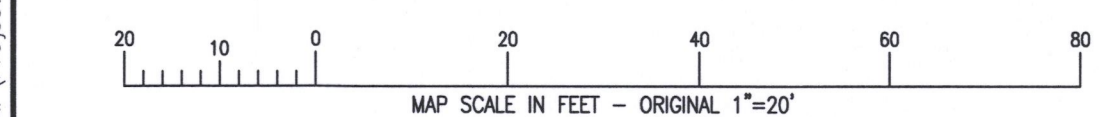

ZYOP-118K

007-392