




LOCATION: 827 Clover St., Lake Geneva, Wisconsin  
PREPARED FOR: Michael Parent - D'Aprile Properties  
LEGAL DESCRIPTION:

Part of Lot 12 of Second Columbian Subdivision described as Follows:

A strip of land of uniform width, 50 feet wide North and South off the South side of the West 1/2 of Lot 12 in the Second Columbian Subdivision. Said land being in the city of Lake Geneva, Walworth County, Wisconsin.

**CURRENT OWNER:** Joshua M. Gaido


TAX ID: ZCL2 00009

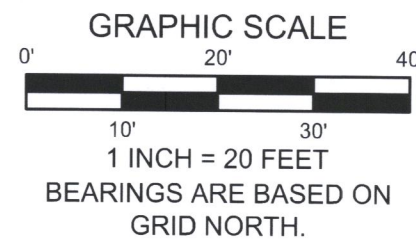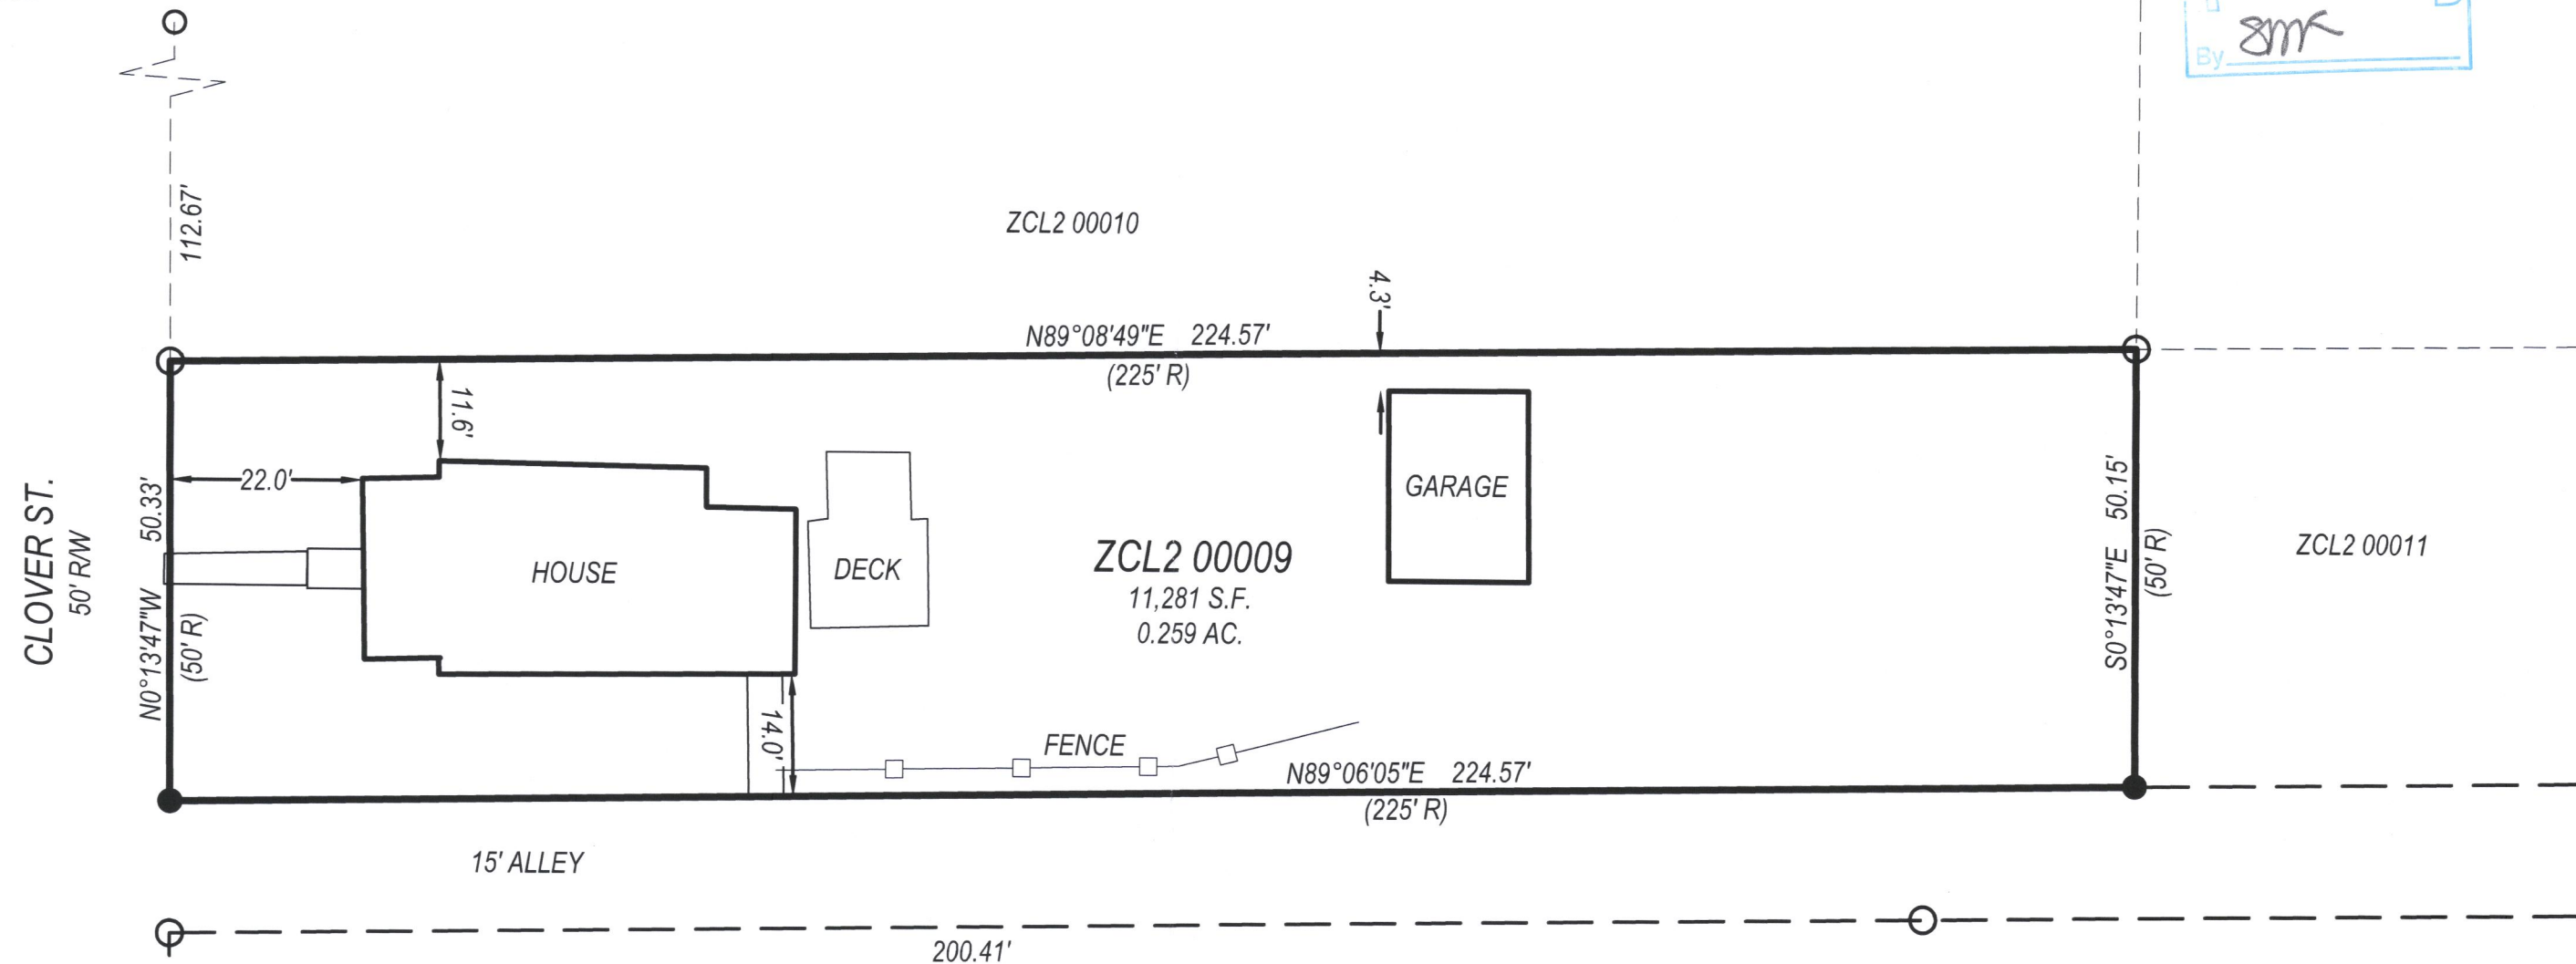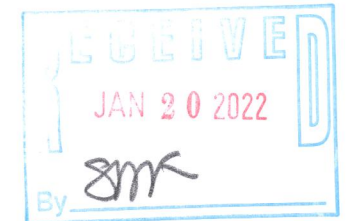

**LEGEND**

(XX R)

FOUND 1" IRON PIPE  
RECORDED AS  
SET 3/4" REBAR

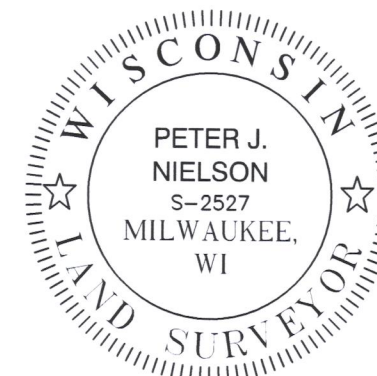

*I have surveyed the above-described property and the above map is a true representation thereof and shows the size and location of the property, its exterior boundaries, the location and dimensions of all structures thereon, fences, apparent easements and roadways, and visible encroachments, if any.*

No title commitment or results of a title search were provided to this office pertaining to this survey. This Plat Of Survey may not reflect easements of record, encumbrances, restrictions, ownership, title evidence, or other facts that a current and accurate title search may disclose.

*This survey is made for the exclusive use of the present owners of the property, and also those who purchase, mortgage, or insure the title thereto within one (1) year from date hereof; and as to them I warrant the accuracy of said survey map.*

DRAWING BY:  
FIELD WORK BY:

PETER J. NIELSON, PROFESSIONAL LAND SURVEYOR, S-2527

ZOLA-9