

# ALTA/NSPS Land Title Survey

A parcel of land described in Schedule A of Title Commitment No. WA-21002, Revision A, prepared by Chicago Title Insurance Company, dated March 18, 2022, as shown below:

Parcel B:


A parcel of land located in the Northwest 1/4 of Section 6, Town 1 North, Range 18 East, City of Lake Geneva, Walworth County, Wisconsin, being more particularly described as:

Commencing at the South 1/4 corner of said Section 6; thence North 2° 19' 14" West 2642.09 feet to the center of said Section 6; thence North 2° 38' 45" West 751.80 feet; thence North 39° 57' 15" West 462.74 feet to a point on the Southwesterly right of way line of the Chicago and Northwestern Railroad; thence South 86° 04' 55" West 551.91 feet to the place of beginning; thence continue South 86° 04' 55" West 449.09 feet; thence North 3° 54' 20" West 220.11 feet; thence North 86° 04' 55" East 380.18 feet; thence South 16° 16' 35" East 121.03 feet to the arc of a 60 foot radius Cul-de-Sac; thence 140.61 feet along the said arc to the left, the chord which bears South 26° 46' 50" East 110.57 feet, to the place of beginning.


Tax Key No.: ZYUP 00145E  
Address: 1012 Host Drive

Schedule B - Part II of Title Commitment No. WA-21002, Revision A, prepared by Chicago Title Insurance Company, dated March 18, 2022, lists no easements and restrictions on this property.

North 1/4 Corner  
Section 6-1-18  
N. 216,289.51  
E. 2,427,204.18

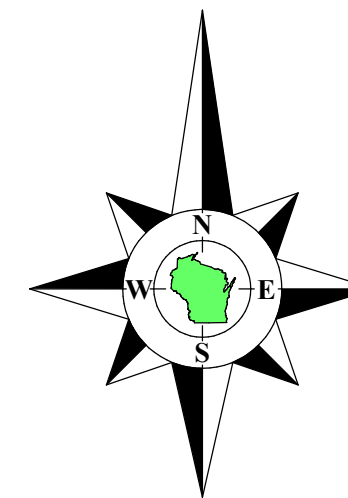

Bearings referenced to the East line of the Northwest 1/4 of Section 6-1-18, recorded as N2°40'33"W in the Wisconsin State Plane Coordinate System, South Zone, (NAD-27).  
Coordinates are referenced to the Wisconsin State Plane Coordinate System, South Zone, (NAD-27).

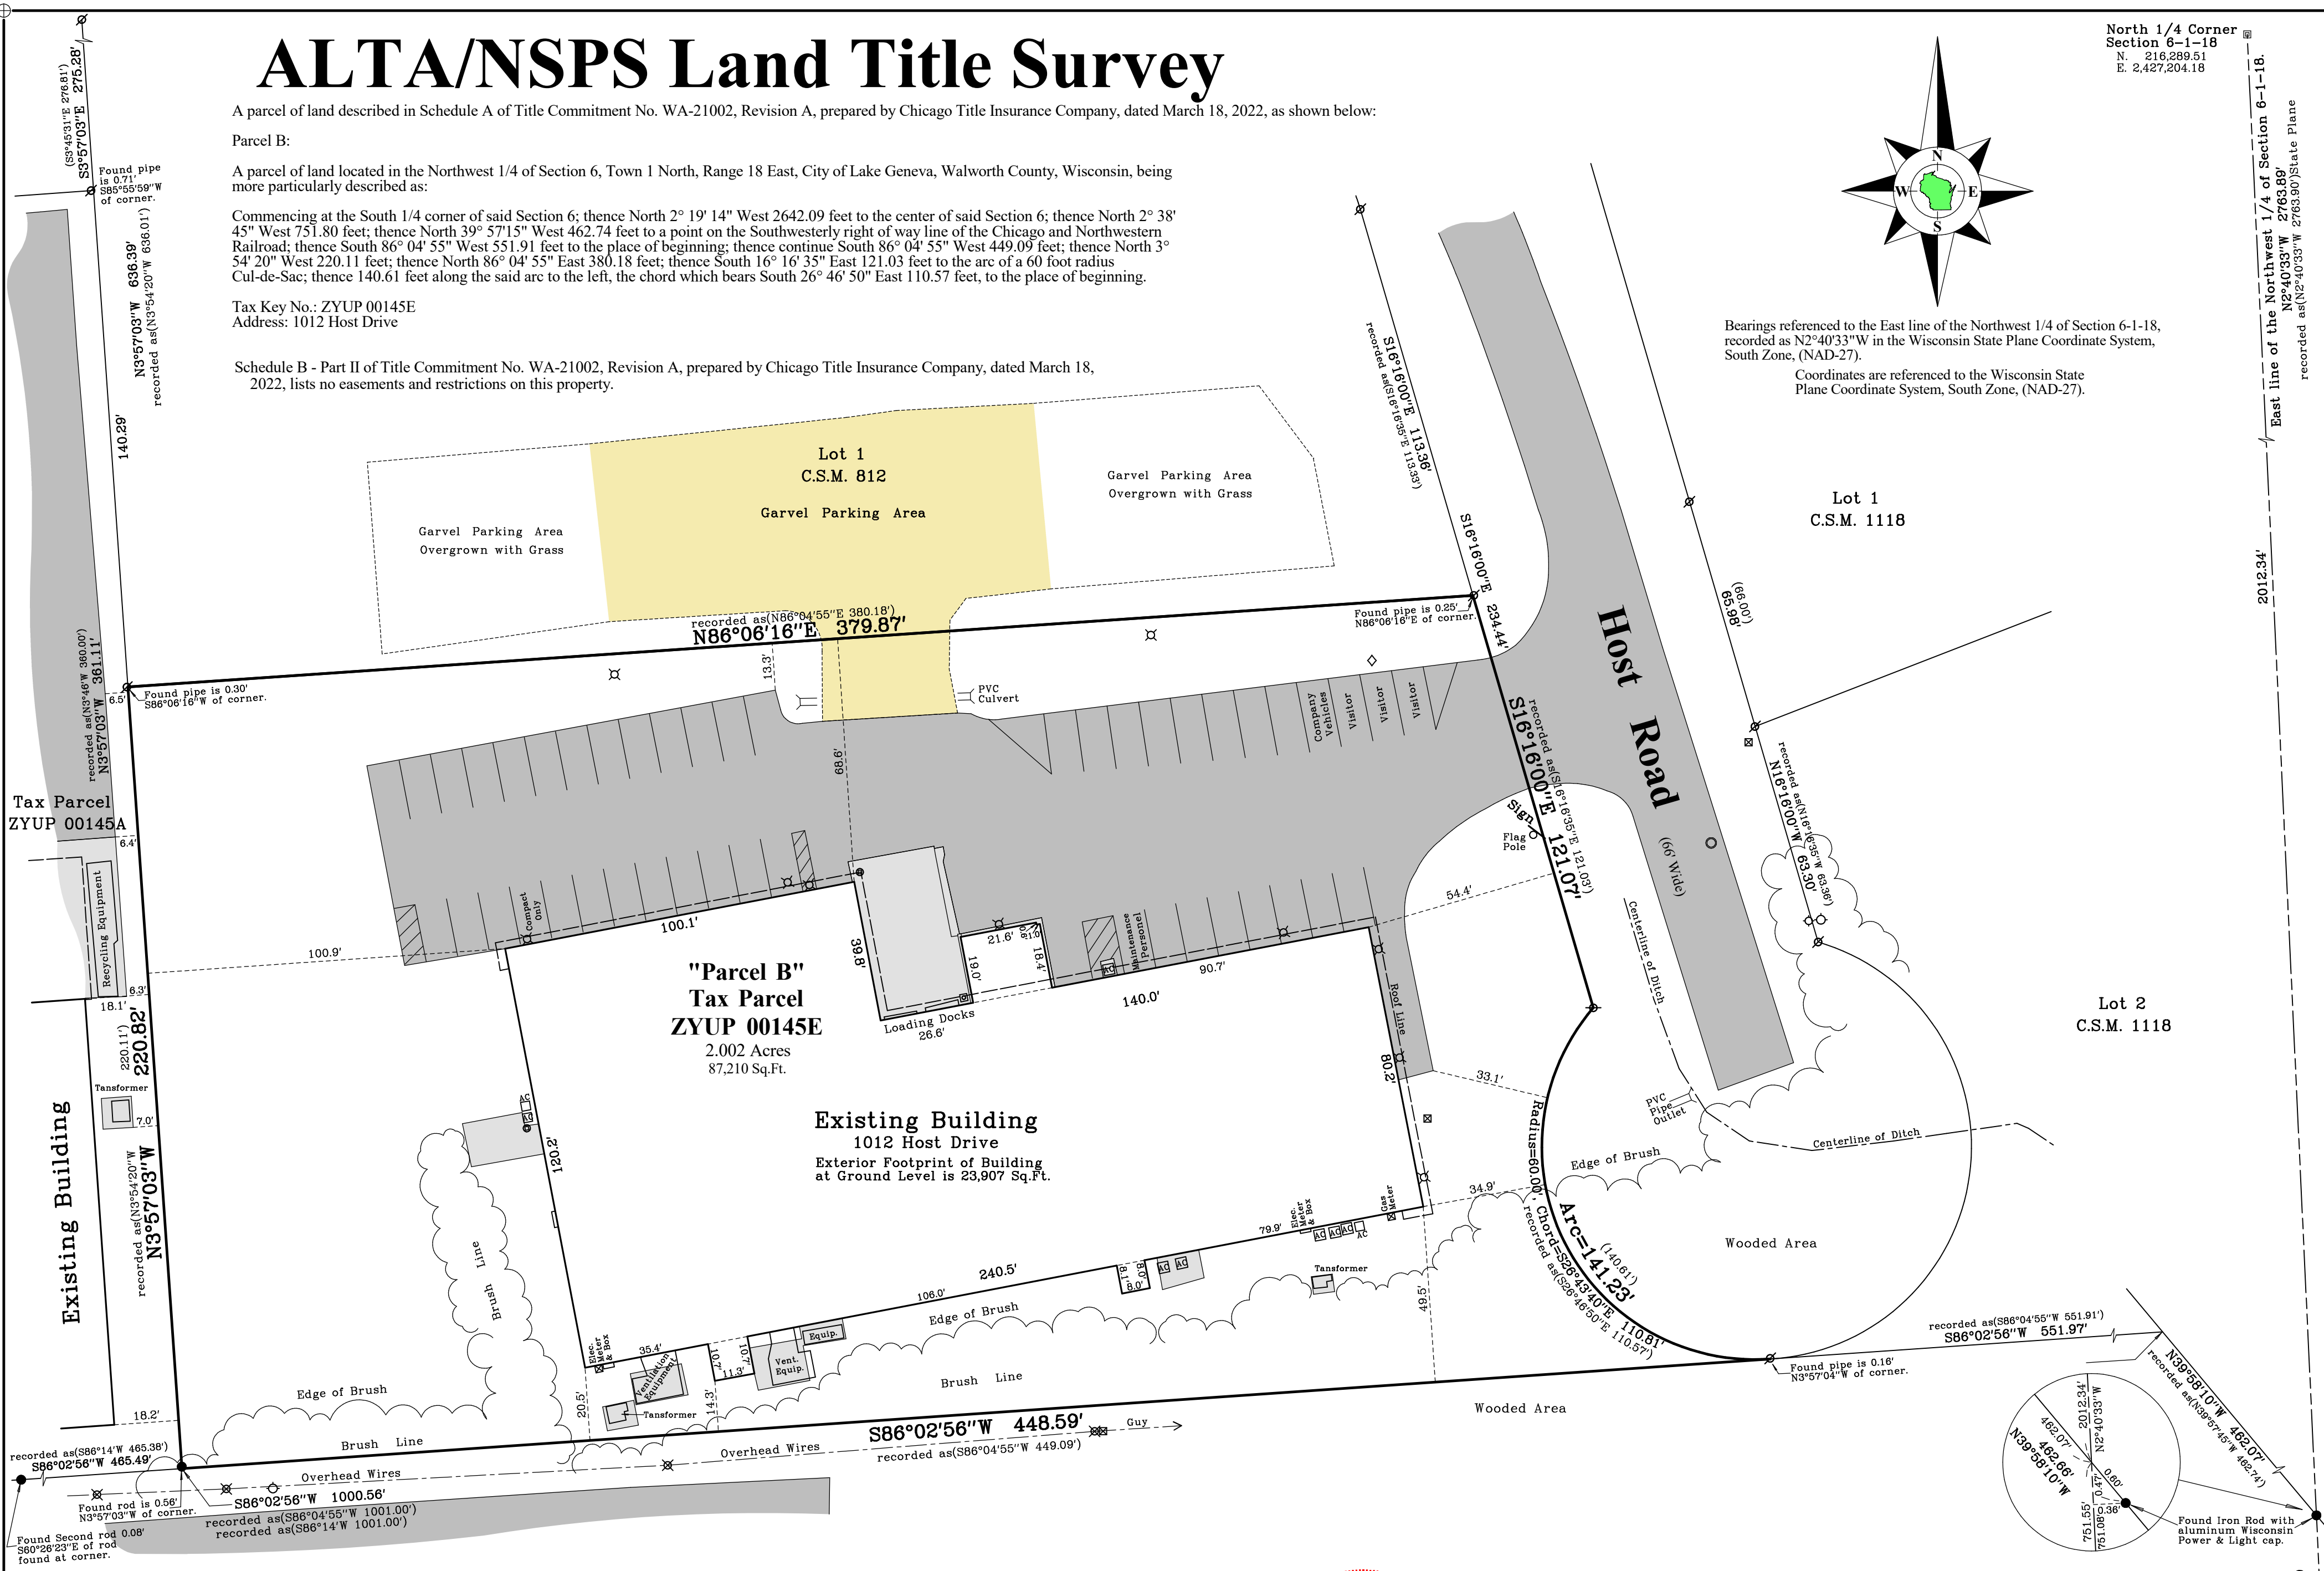


Tax Parcel  
ZYUP 00145A

"Parcel B"  
Tax Parcel  
ZYUP 00145E  
2.002 Acres  
87,210 Sq.Ft.

Existing Building  
1012 Host Drive  
Exterior Footprint of Building  
at Ground Level is 23,907 Sq.Ft.

Tax Parcel  
ZYUP 00142

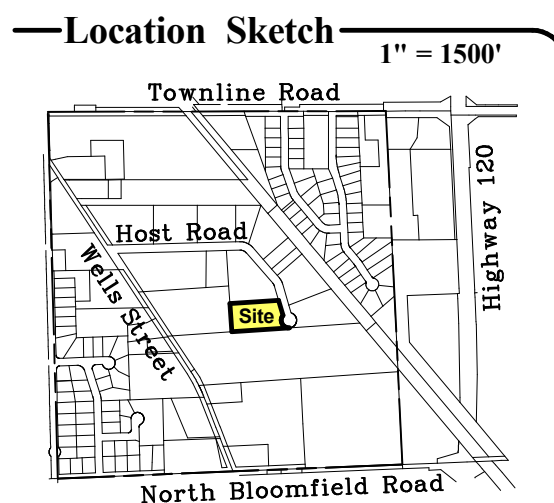

- Notes:
- According to Flood Insurance Rate Map (FIRM) No. 55127C0333D for Walworth County, City of Lake Geneva, Effective date: October 2, 2009, this site falls in Zone X: Areas determined to be outside the 0.2% annual chance floodplain.
  - There are 40 regular, 3 visitor, 1 company vehicle, 1 maintenance personel, 1 compact car and no handicapped marked parking spaces on this site.
  - Centerline of ditch shown indicates a small ditch through which water appears to flow to a low area on Tax Parcel ZA111800002.
  - The gravel parking area on the parcel to the North appears to be used as parking for this property.



To: Primex, Inc.  
Chicago Title Insurance Company

This is to certify that this map or plat and the survey on which it is based were made in accordance with the 2021 Minimum Standard Detail Requirements for ALTA/NSPS Land Title Surveys, jointly established and adopted by ALTA and NSPS, and includes items 1, 2, 3, 4, 7(a), 7(b)(1), 8 and 9 of Table A thereof.


The field work was completed on April 11, 2022.

April 11, 2022.

Douglas G. Olson  
Wisconsin Professional Land Surveyor - 2093

Center 1/4 Corner  
Section 6-1-18  
N. 213,528.65  
E. 2,427,333.21

Survey Date: April 11, 2022.  
Revisions:

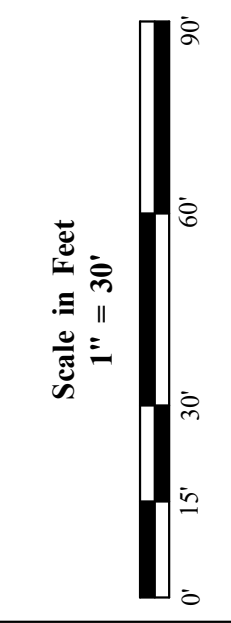

45 South Wisconsin Street | P.O. Box 322  
Elkhorn, Wisconsin, 53121  
Telephone: (262) 723-3434  
Facsimile: (262) 723-8044  
Email: doug@olsonsurveying.com  
Website: www.olsonsurveying.com



- Legend of Symbols & Abbreviations
- Found County Section Corner
  - Found Iron Pipe
  - Found Iron Rod
  - Set Iron Pipe, 1" dia.
  - Set Iron Rod, 1/2" dia.
  - Utility Pole
  - Light Pole
  - Bollard
  - Manhole
  - PVC Cap
  - Fire Hydrant
  - Manhole
  - Water Valve
  - Catch Basin
  - Gravel
  - Asphalt Surface
  - Concrete

Sheet 1 of 1 Sheets  
Drawing Name:  
Job Reference Number  
2022.035  
2022.035