

ALTA/NSPS Land Title Survey

A parcel of land described in Schedule A of Title Commitment No. WA-21002, Revision A, prepared by Chicago Title Insurance Company, dated March 18, 2022, as shown below:

Parcel B:

A parcel of land located in the Northwest 1/4 of Section 6, Town 1 North, Range 18 East, City of Lake Geneva, Walworth County, Wisconsin, being more particularly described as:

Commencing at the South 1/4 corner of said Section 6; thence North 2° 19' 14" West 2642.09 feet to the center of said Section 6; thence North 2° 38' 45" West 751.80 feet; thence North 39° 57' 15" West 462.74 feet to a point on the Southwesterly right of way line of the Chicago and Northwestern Railroad; thence South 86° 04' 55" West 551.91 feet to the place of beginning; thence continue South 86° 04' 55" West 449.09 feet; thence North 3° 54' 20" West 220.11 feet; thence North 86° 04' 55" East 380.18 feet; thence South 16° 16' 35" East 121.03 feet to the arc of a 60 foot radius Cul-de-Sac; thence 140.61 feet along the said arc to the left, the chord which bears South 26° 46' 50" East 110.57 feet, to the place of beginning.


Tax Key No.: ZYUP 00145E
Address: 1012 Host Drive

Schedule B - Part II of Title Commitment No. WA-21002, Revision A, prepared by Chicago Title Insurance Company, dated March 18, 2022, lists no easements and restrictions on this property.

Legal Description of Proposed Lot Line Adjustment



Part of Lot 1 of Certified Survey Map No. 812, located in the Northwest 1/4 of Section 6, Town 1 North, Range 18 East, City of Lake Geneva, Walworth County, Wisconsin, described as follows: Begin at the Southwest corner of said Lot 1; thence North 3° 57' 03" West, along the West line of said Lot 1, 71.33 feet to an iron pipe; thence North 86° 06' 16" East 364.29 feet to an iron pipe on the East line of said Lot 1; thence South 16° 16' 00" East, along said East line, 73.02 feet to the Southeast corner of said Lot 1; thence South 86° 06' 16" West, along the South line of said Lot 1, 379.87 feet to the Point of Beginning.

North 1/4 Corner
Section 6-1-18
N. 216,289.51
E. 2,427,204.18

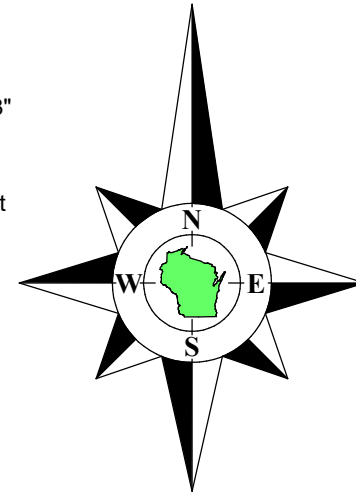


Bearings referenced to the East line of the Northwest 1/4 of Section 6-1-18, recorded as N2°40'33"W in the Wisconsin State Plane Coordinate System, South Zone, (NAD-27).

Coordinates are referenced to the Wisconsin State Plane Coordinate System, South Zone, (NAD-27).

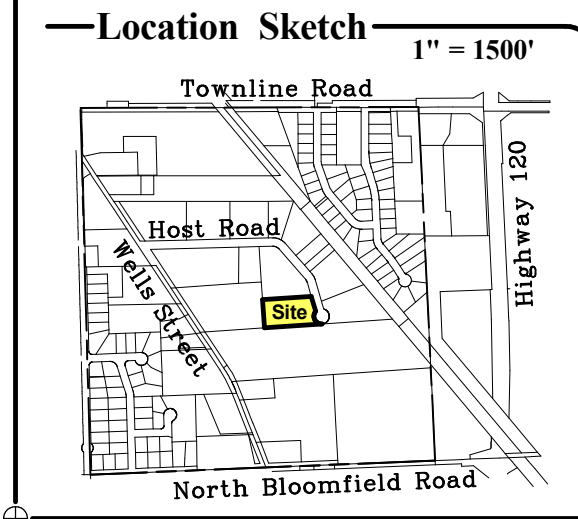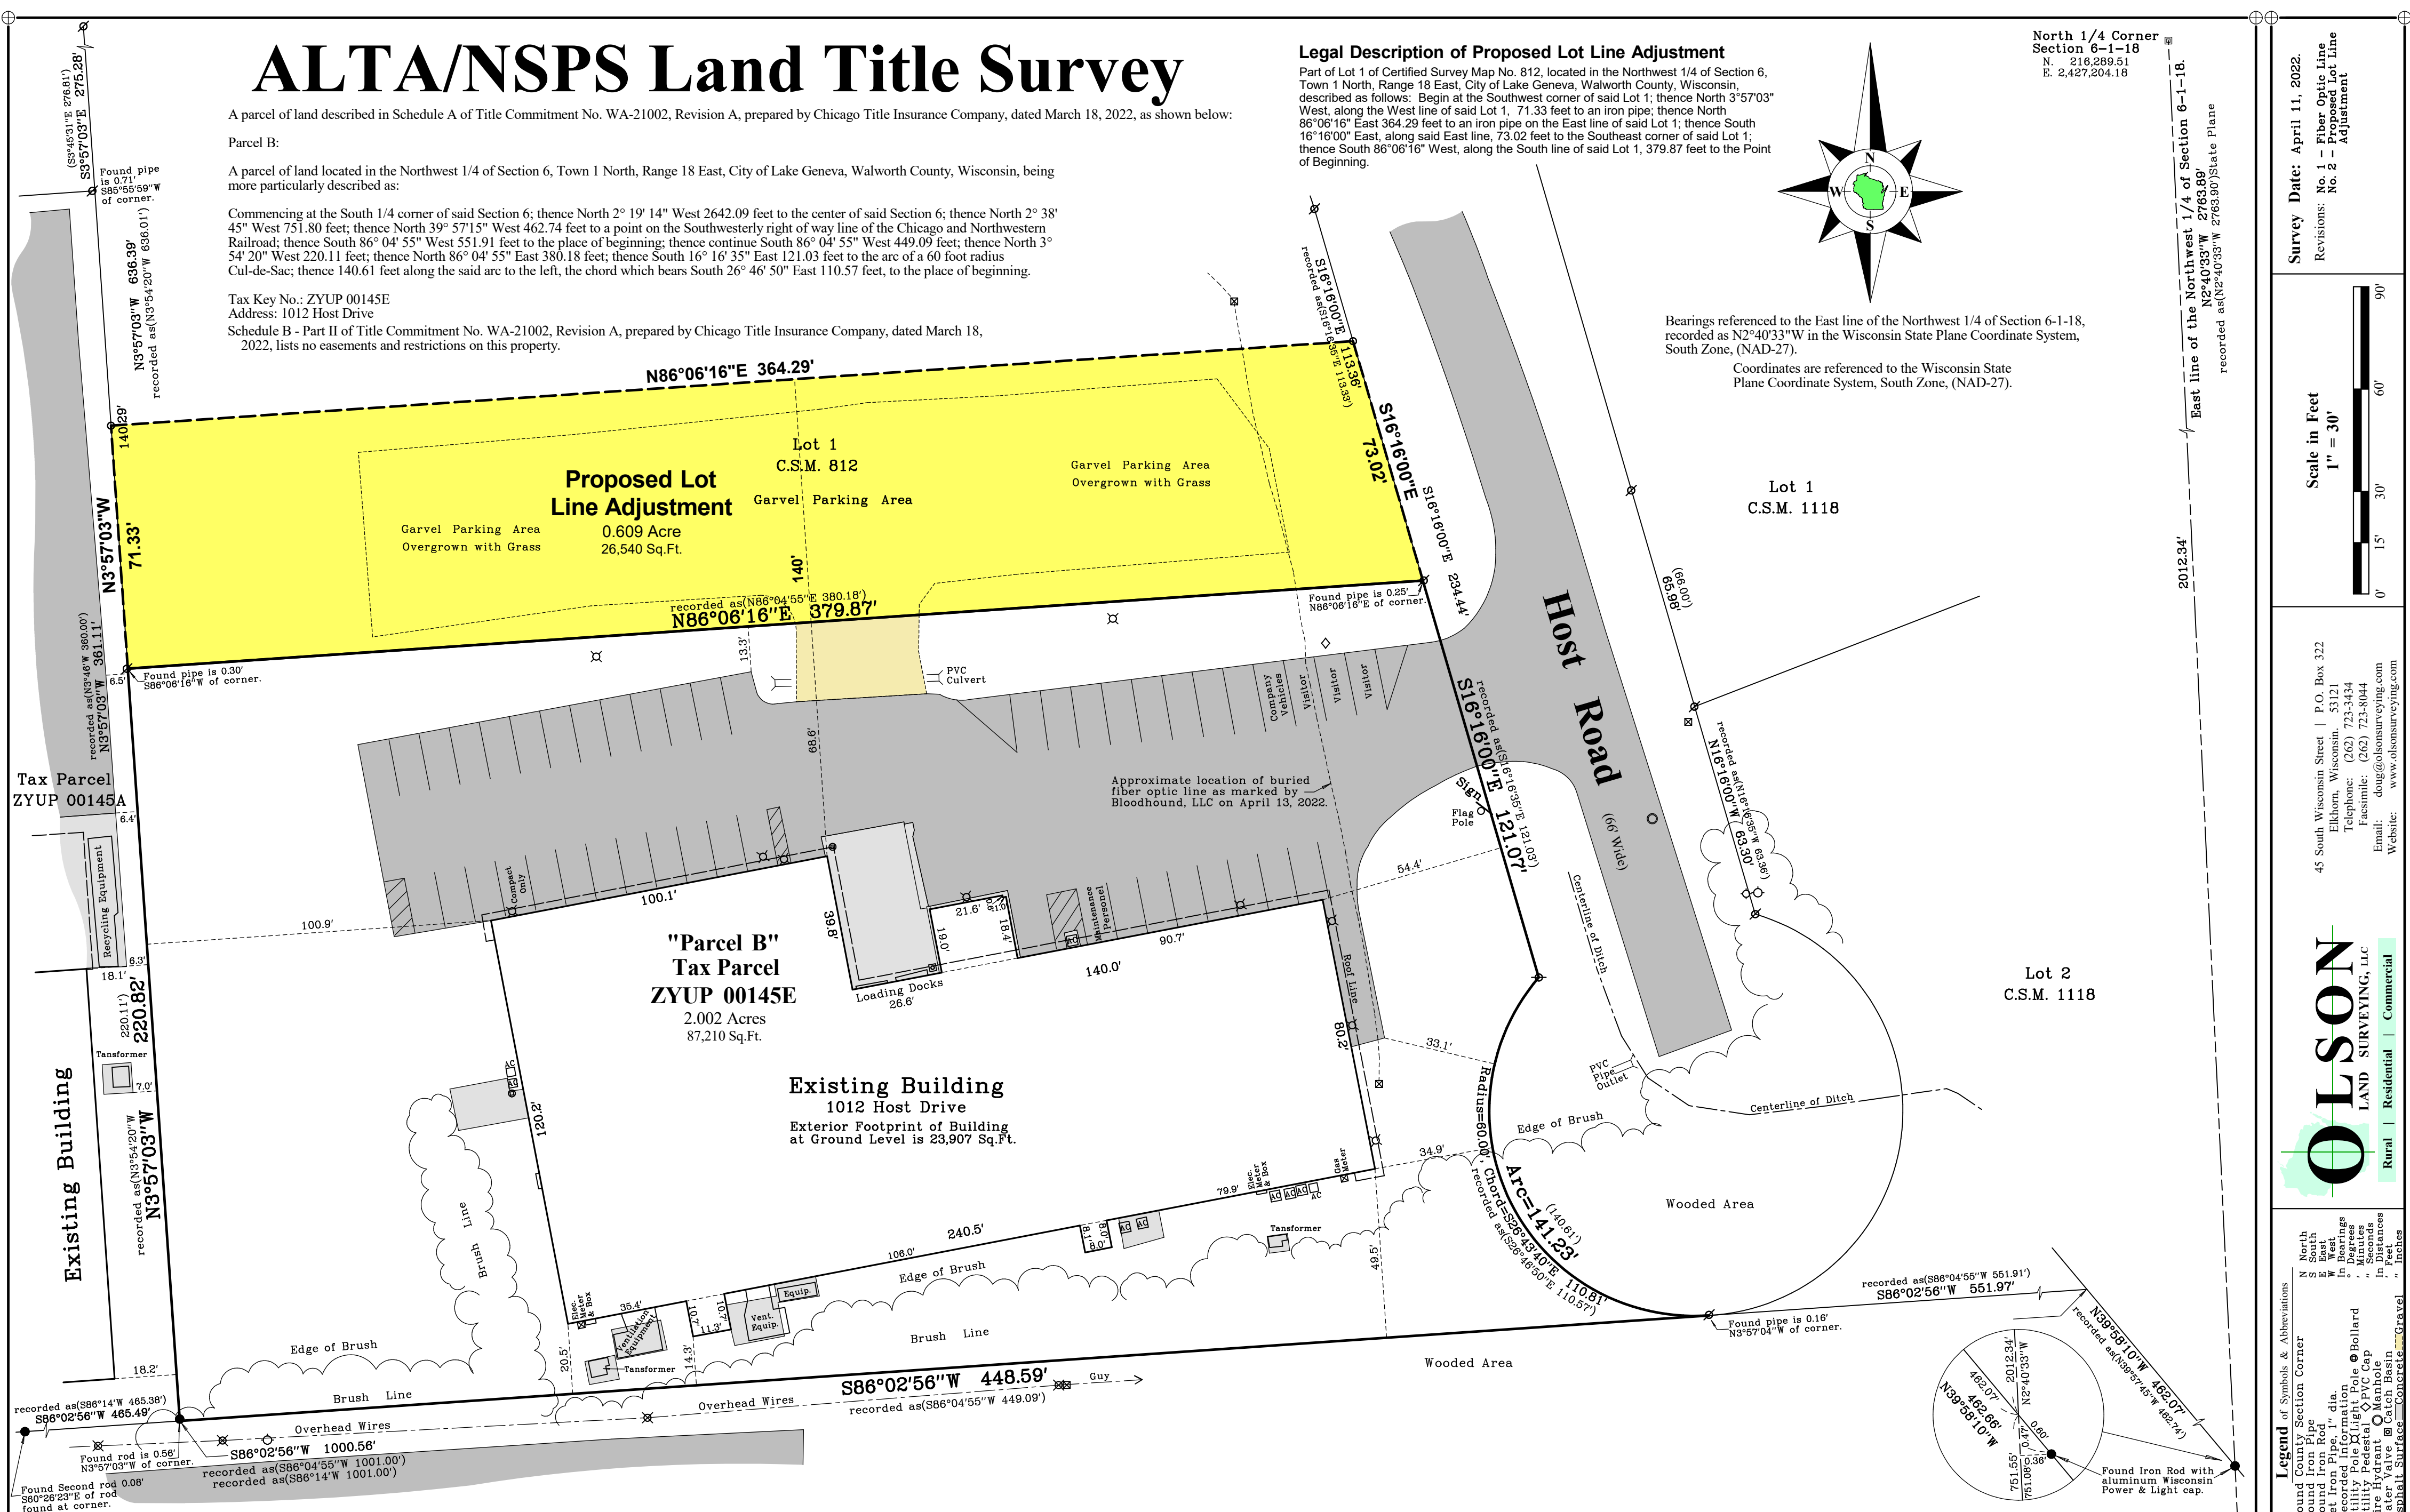

- Notes:
- According to Flood Insurance Rate Map (FIRM) No. 55127C0333D for Walworth County, City of Lake Geneva, Effective date: October 2, 2009, this site falls in Zone X: Areas determined to be outside the 0.2% annual chance floodplain.
 - There are 40 regular, 3 visitor, 1 company vehicle, 1 maintenance personnel, 1 compact car and no handicapped marked parking spaces on this site.
 - Centerline of ditch shown indicates a small ditch through which water appears to flow to a low area on Tax Parcel ZA111800002.
 - The gravel parking area on the parcel to the North appears to be used as parking for this property.

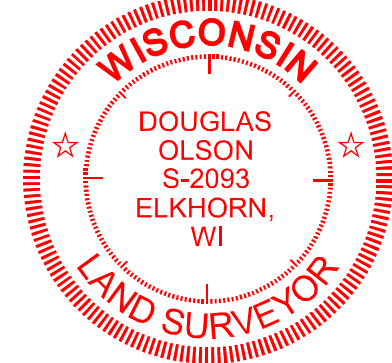

To: Primex, Inc.
Chicago Title Insurance Company

This is to certify that this map or plat and the survey on which it is based were made in accordance with the 2021 Minimum Standard Detail Requirements for ALTA/NSPS Land Title Surveys, jointly established and adopted by ALTA and NSPS, and includes items 1, 2, 3, 4, 7(a), 7(b)(1), 8 and 9 of Table A thereof.


The field work was completed on April 11, 2022.

April 11, 2022.


Douglas G. Olson
Wisconsin Professional Land Surveyor - 2093

Center 1/4 Corner
Section 6-1-18
N. 213,528.65
E. 2,427,333.21

Survey Date: April 11, 2022.
Revisions: No. 1 - Fiber Optic Line
No. 2 - Proposed Lot Line Adjustment

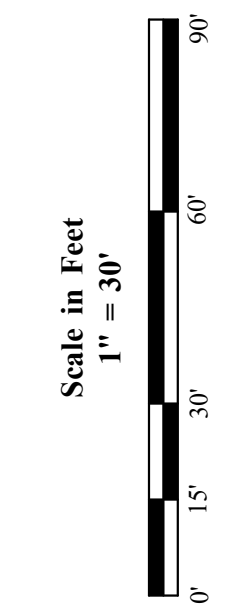

45 South Wisconsin Street | P.O. Box 322
Elkhorn, Wisconsin, 53121
Telephone: (262) 723-3434
Facsimile: (262) 723-8044
Email: doug@olsonsurveying.com
Website: www.olsonsurveying.com

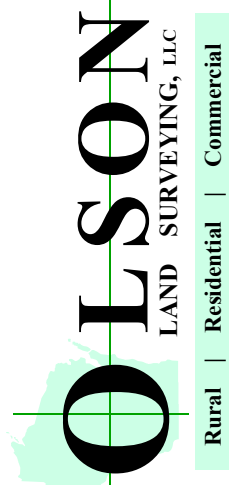

Legend of Symbols & Abbreviations:
 North Corner
 Section Corner
 Found County Rod
 Found Iron Rod
 Set Iron Pipe, 1" dia.
 Recorded Information
 Utility Pole (Light Pole)
 Fire Hydrant
 Water Valve
 Manhole
 Asphalt Surface
 Concrete
 Gravel

Sheet 1 of 1 Sheets
Job Reference Number
2022.035
2022.035