
## HAROLD H. KOLB

## REGISTERED PROFESSIONAL LAND SURVEYOR LAKE GENEVA, WISCONSIN

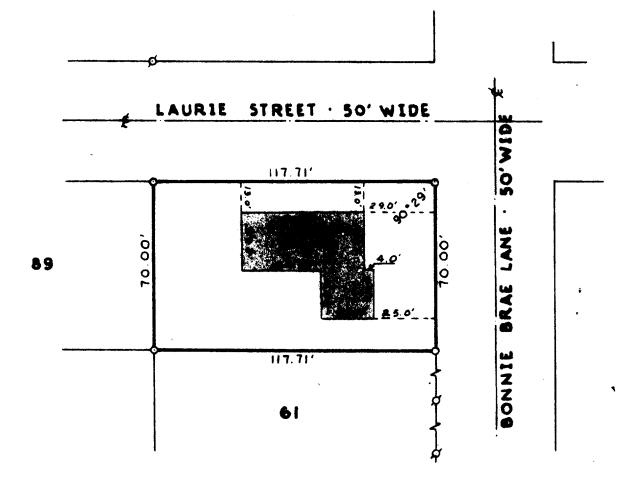

PLAT OF SURVEY OF

N

SCALE: I":401

Lot 62, H. E. Wells Addition to the City of Lake Geneva, Walworth County, Wisconsin,

## LECENO

- . IRON PIPE FOUND
- O IRON PIPE PLACED
- CONCRETE MONUMENT
- X SPIKE



I. HAROLD M. KOLB, DO HEREBY CERTIFY THAT I HAVE SURVEYED THE PROPERTY HEREON DESCRIBED ACCORDING TO THE OFFICIAL RECORDS, AND THAT THE PLAT HEREON IS A CORRECT REPRESENTATION OF THE LOT LINES.

HAROLD H. KOLB WISCONSIN REGISTERED LAND SURVEYOR, S-187 DATE March 21, 1973

7-44

BRUNING 40-106 1M-6-71