


PLAT OF SURVEY

Lot 707 in Symphony Bay Encore, a redivision of Outlot 5 Symphony Bay Subdivision located in the Southwest Quarter of the Northwest Quarter of Section 5 and the Southeast Quarter of the Northeast Quarter of Section 6, all in Township 1 North, Range 18 East, according to the Plat thereof recorded March 16, 2023 as Document No. 1076251, in the City of Lake Geneva, Walworth County, Wisconsin.

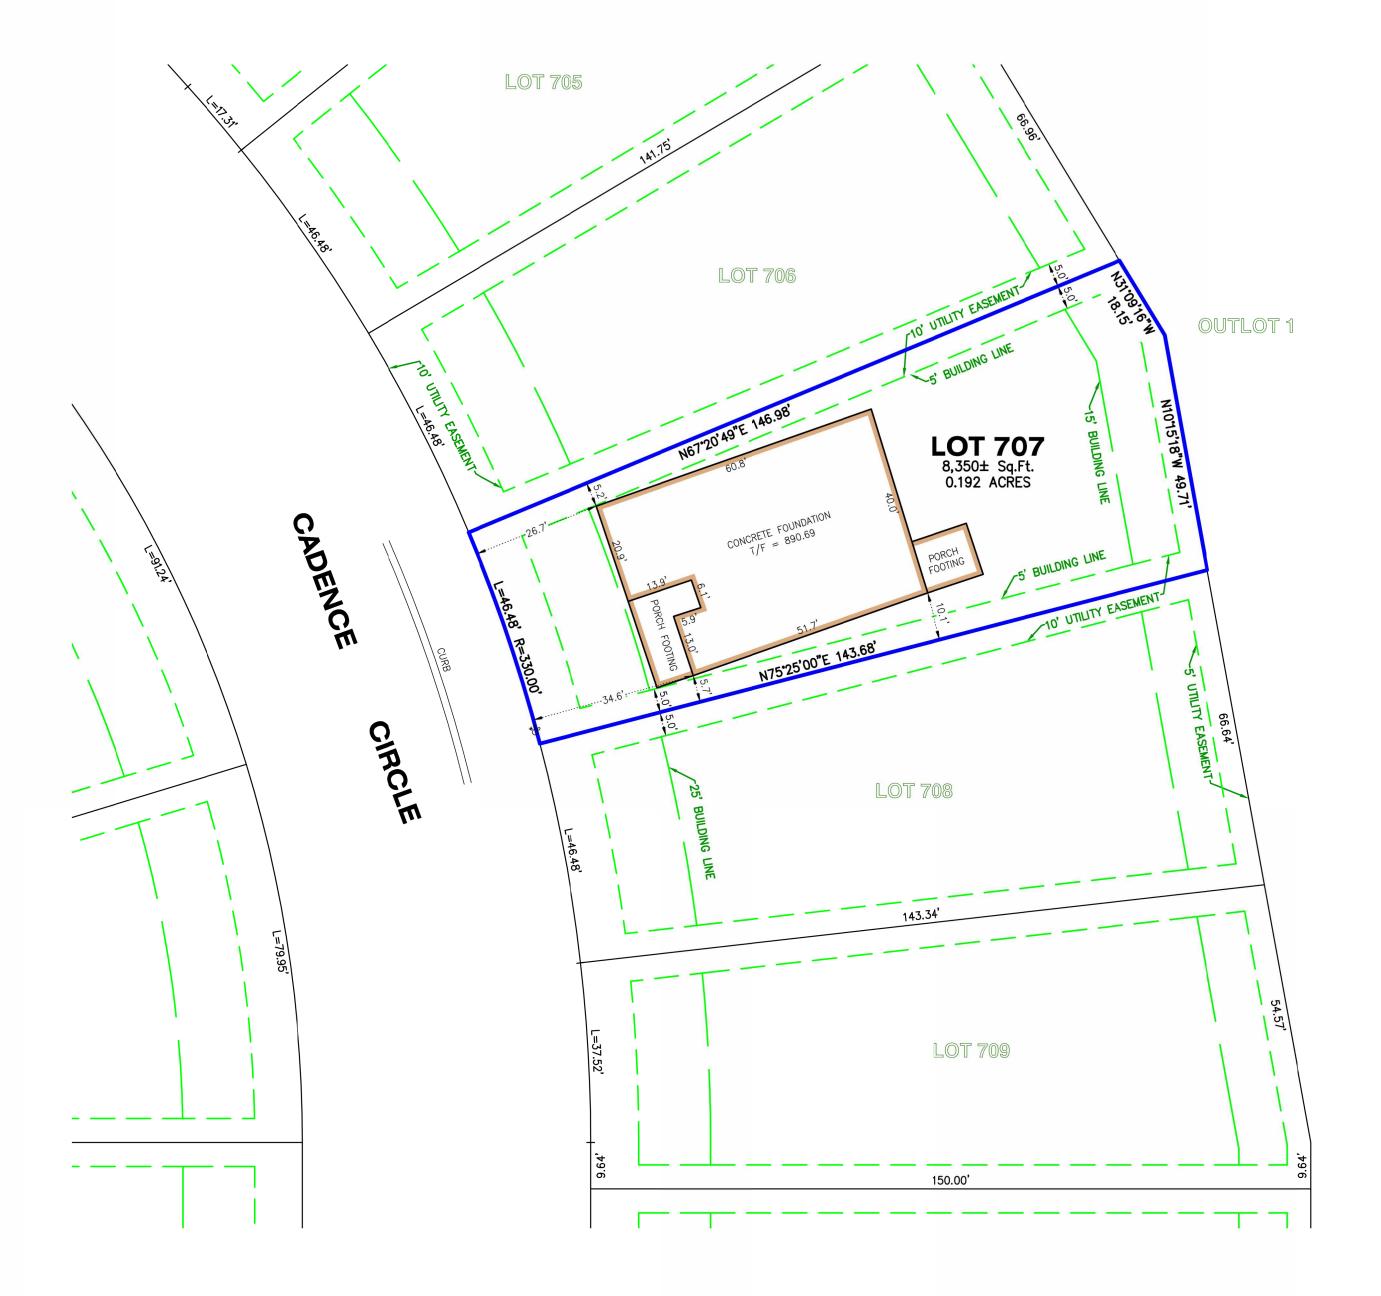

LEGEND		
•	CATCH BASIN	
	CURB INLET	
	ELECTRIC RISER	
450	WATER SHIIT-OFF	

DRAWN BY: CKV CHECKED BY: APG SCALE: <u>1"=20</u>' BASIS OF BEARING: PER RECORD SUBDIVISION P.I.N.: ZSBE 00707

JOB NO.: 170870.707-A

20'	0'	20'	40'
	SCALE:	1" = 20'	

ALL ELEVATIONS SHOWN ARE PER FINAL ENGINEERING PLANS BY KAPUR & ASSOCIATES, JOB NO. 15.0201.07 DATED 09/01/2022

CORNERS TO BE SET AT TIME OF FINAL SURVEY

NOTE: Only those Building Line Restrictions or Easements shown on a Recorded Subdivision Plat are shown hereon unless the description ordered to be surveyed contains a proper description of the required building lines or easements.

* No distance should be assumed by scaling.

* No underground improvements have been located unless shown and noted.

* No representation as to ownership, use, or possession should be hereon implied.

* This Survey and Plat of Survey are void without original embossed or colored seal and signature affixed.

Compare your description and site markings with this plat and AT ONCE report any discrepancies which you may find.



STATE OF ILLINOIS) S.S. COUNTY OF McHENRY)

In my professional opinion, and based on my observations, I hereby certify that the above described property has been surveyed under my direction and that the above map is a true representation thereof and shows the size and location of all visible structures, and dimensions of all principle buildings thereon, boundary fences, apparent easements, roadways, and visible encroachments, if any. This survey is made for the use of the present owners of the property, and also those who purchase, mortgage, or guarantee the title thereto within one year from the date hereof.

Dated at Woodstock, McHenry County, Illinois 1/28 A.D., 2025.

Vanderstappen Land Surveying, Inc. Design Firm No. 184-002792

Wisconsin Registered Land Surveyor No. S3021

CLIENT: FAIRWYN DEVELOPMENT

SEC. 5,6 T. 01 R. 18 E.

FIELDWORK COMP.: 1/28/25 BK. _ ALL DISTANCES SHOWN IN FEET AND DECIMAL REF: 170870 PARTS THEREOF CORRECTED TO 68° F.