


BLOCK #1

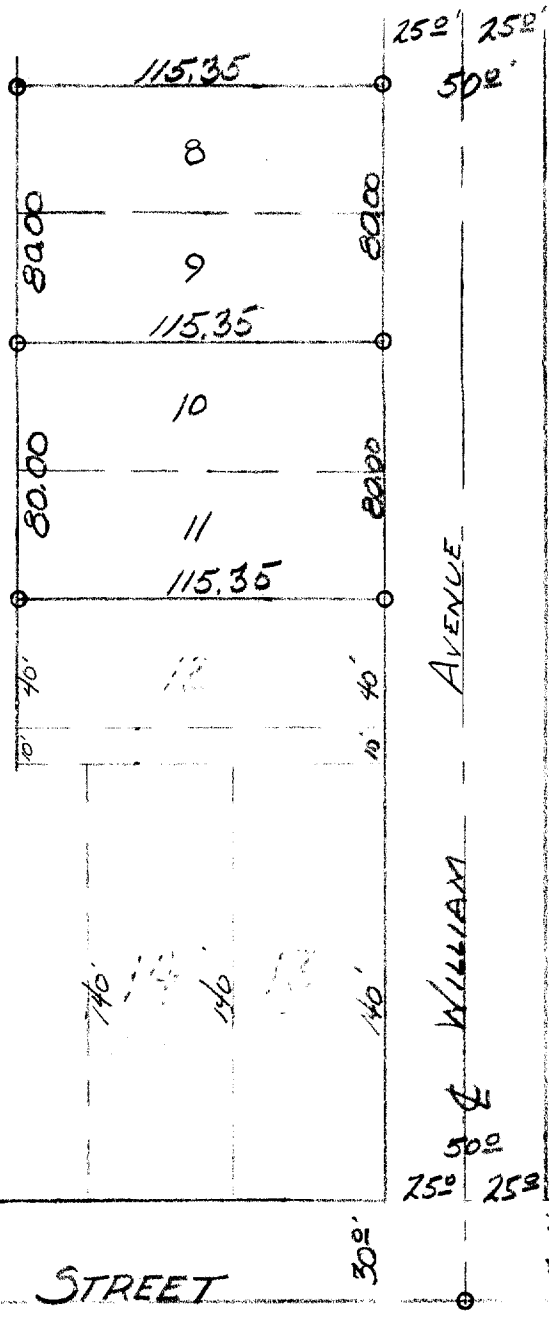


o - Indicates Iron Stake

DESCRIPTIION: Lots 8, 9, 10, and 11 of Block No. 1 of Lake Geneva Hills Subdivision, in the City of Lake Geneva, Walworth County, Wisconsin.

CERTIFICATE: I hereby certify that I have on this 19th day of November 1958 surveyed the above described property in accordance with the official records on file in the Register of Deeds office, Walworth County.

SIGNED AND SEALED THIS 21ST DAY OF NOVEMBER 1958.

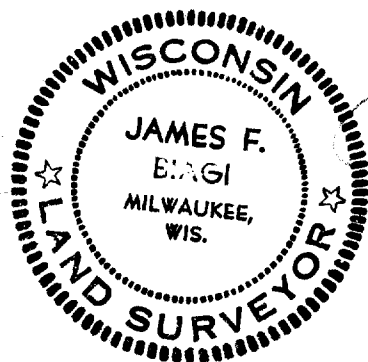

James F. Biagi
R. L. S. 272