


# HAROLD H. KOLB

REGISTERED PROFESSIONAL LAND SURVEYOR  
LAKE GENEVA, WISCONSIN

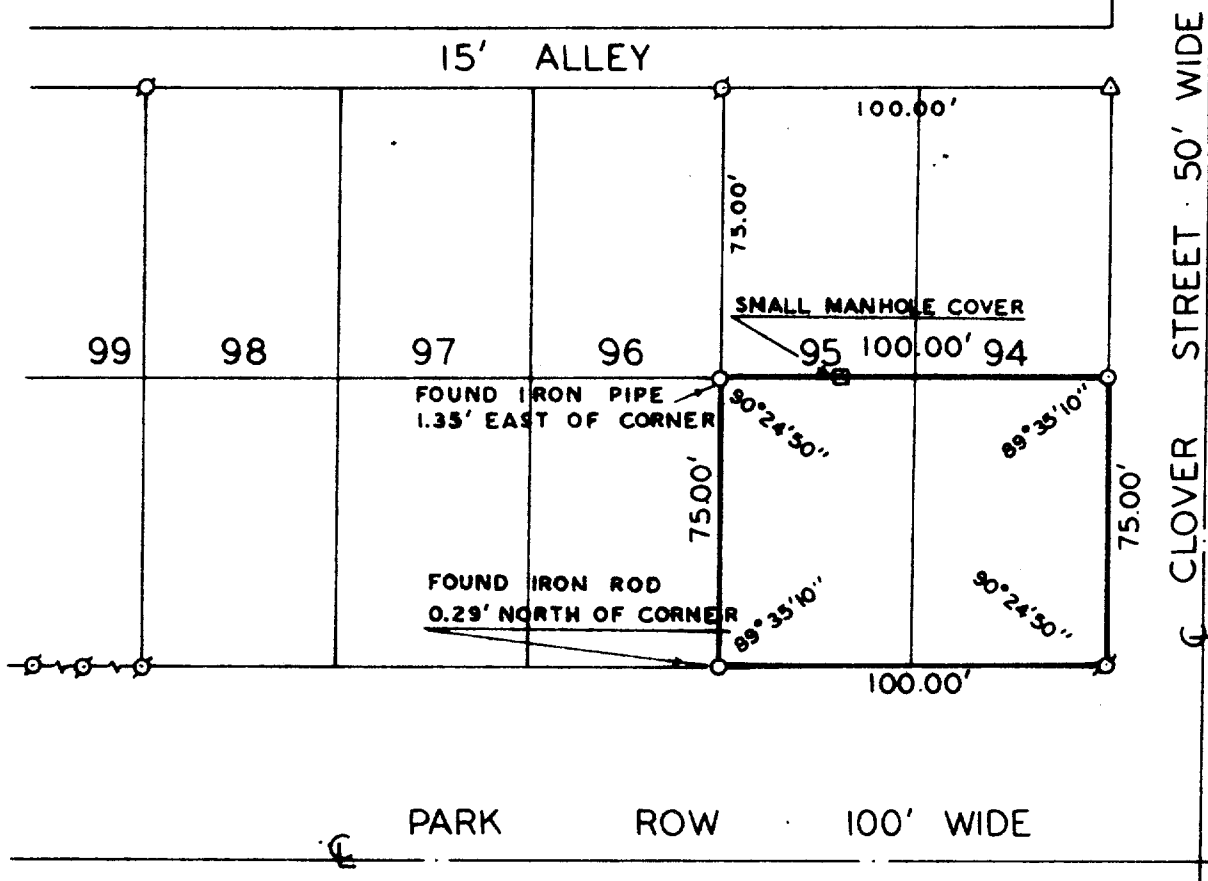

## PLAT OF SURVEY OF


THE SOUTH  $\frac{1}{2}$  OF LOTS 94 AND 95, COLUMBIAN  
SUBDIVISION, CITY OF LAKE GENEVA, WALWORTH  
COUNTY, WISCONSIN

OWNER: ARCHIE ROBERS  
1128 LAKE GENEVA BLVD.  
LAKE GENEVA, WI 53147

ACCURACY: DISTANCE 0.01'  
ANGLES 05"  
ERROR OF CLOSURE LESS THAN 1/3000

**N**  
  
SCALE 1"=50'  
LEGEND

- φ - IRON PIPE FOUND
- - IRON PIPE PLACED
- - CONCRETE MONUMENT
- x - SPIKE
- Δ - IRON ROD FOUND

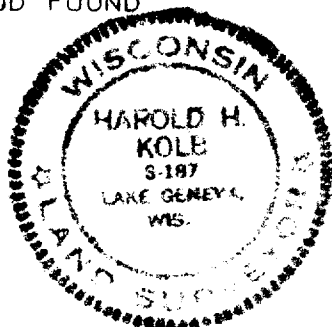

I, HAROLD H. KOLB, DO HEREBY CERTIFY THAT I HAVE  
SURVEYED THE PROPERTY HEREON DESCRIBED ACCORDING  
TO THE OFFICIAL RECORDS, AND THAT THE PLAT HEREON  
IS A CORRECT REPRESENTATION OF THE LOT LINES.

*Harold H. Kolb*  
HAROLD H. KOLB  
WISCONSIN REGISTERED LAND SURVEYOR, S-187  
DATE Sept 19, 1975

CL-76A

7-521