


HAROLD H. KOLB

REGISTERED PROFESSIONAL LAND SURVEYOR
LAKE GENEVA, WISCONSIN

WILLIAM STREET

G

GARDNER STREET

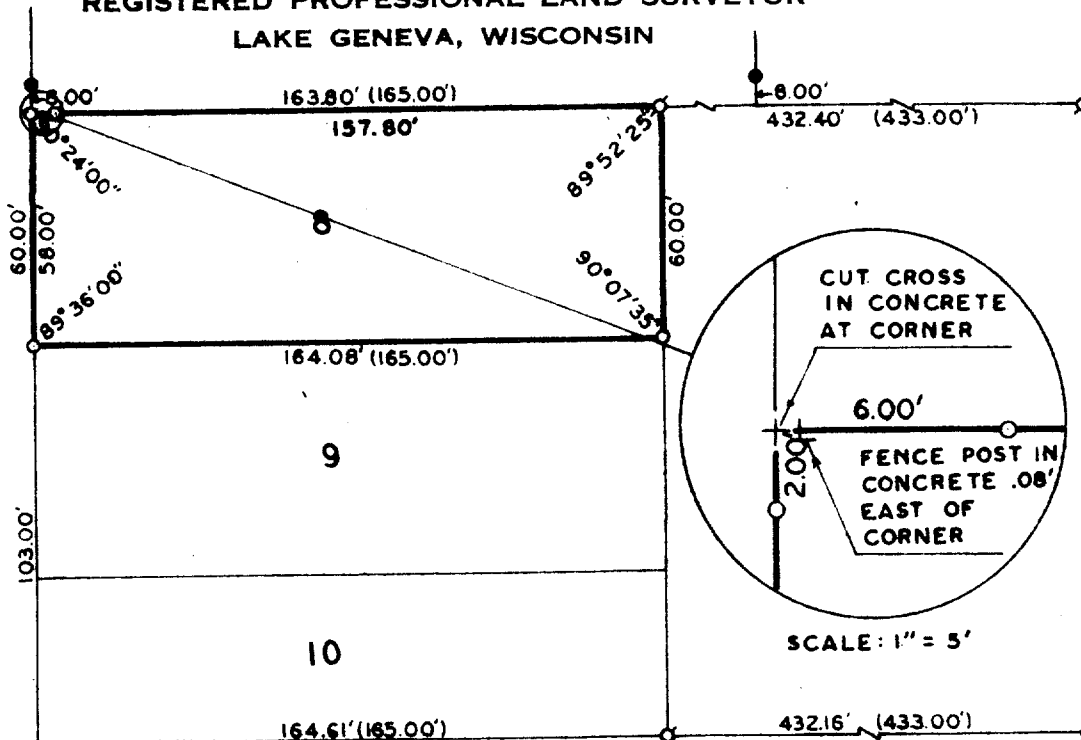

PLAT OF SURVEY OF

LOT 8, GARDNERS ADDITION, CITY
OF LAKE GENEVA, WALWORTH COUNTY,
WISCONSIN.

OWNER: E. M. BELARDI

ACCURACY: DISTANCES $\pm 0.01'$
ANGLES $\pm 05''$
ERROR OF CLOSURE -- LESS
THAN $1/3000$

N



SCALE: 1"=50'
LEGEND

- φ — IRON PIPE FOUND
- — IRON PIPE PLACED
- — IRON ROD FOUND
- x — SPIKE
- () — AS PLATTED



I, HAROLD H. KOLB, DO HEREBY CERTIFY THAT I HAVE
SURVEYED THE PROPERTY HEREON DESCRIBED ACCORDING
TO THE OFFICIAL RECORDS, AND THAT THE PLAT HEREON
IS A CORRECT REPRESENTATION OF THE LOT LINES.

Harold H. Kolb

HAROLD H. KOLB
WISCONSIN REGISTERED LAND SURVEYOR, S-187
DATE Oct. 6, 1975

Revised: Oct. 28, 1975

ZG-6